

National Grid SA-COA

PRODUCTION FILE

Contractor : ABB Contracting Co.

Project : SS 8709- 132/13.8kV in Alkharj City

Contract No : 11131113/00

Substation : 8709

**Subject : 132kV Busbar Protection Set-2 (+BBP2-6)
Relay Panel -6**





POWER SYSTEMS NETWORK MANAGEMENT
PROTECTION AND SUBSTATION AUTOMATION SYSTEMS
WBS NO: S-13656

ABB AUTOMATION COMPANY LTD.
414, AL-KHARJ ROAD
SECOND INDUSTRIAL CITY
RIYADH-11383 K.S.A

CLIENT : SAUDI ELECTRICITY COMPANY CENTRAL OPERATING AREA
CONTRACTOR : ABB Contracting Co
PROJECT : CONSTRUCTION OF NEW 132/13.8kV SS 8709 IN AL-KHARJ CITY
SUBSTATION : S/S 8709
CONTRACT NO. : 11131113/00
TITLE : Assembly Drawing – +BBP2-6
[132KV BUSBAR PROTECTION MAIN-2 BAY UNIT PANEL]

AS-BUILT BY _____ DATE _____ CONTRACT NO. 11131113/00 JOB ORDER NO. S-13656

01	13 49	FACTORY ASBUILT	DRAWN BY RIZ	CHECKED BY KVR
00	13 14	FOR APPROVAL	DATE STARTED 11.04.2013	DATE COMPLETED
REV. NO.	DATE	DESCRIPTION	OPRG. DEPT. CTPD	ENG. DEPT. AUT-PSAC

COVER SHEET


132KV BUSBAR PROTN.MAIN-2 BU PANEL +BBP2-6
S/S 8709 S-13656
RIYADH SAUDI ARABIA

الشركة الوطنية لنقل الكهرباء




INDEX	PLANT NO.	DRAWING NUMBER	SHEET NO.	REV. NO.
-	C421	CD-323015	SHT 1 CONT.	01

DMS VECTOR NGD200

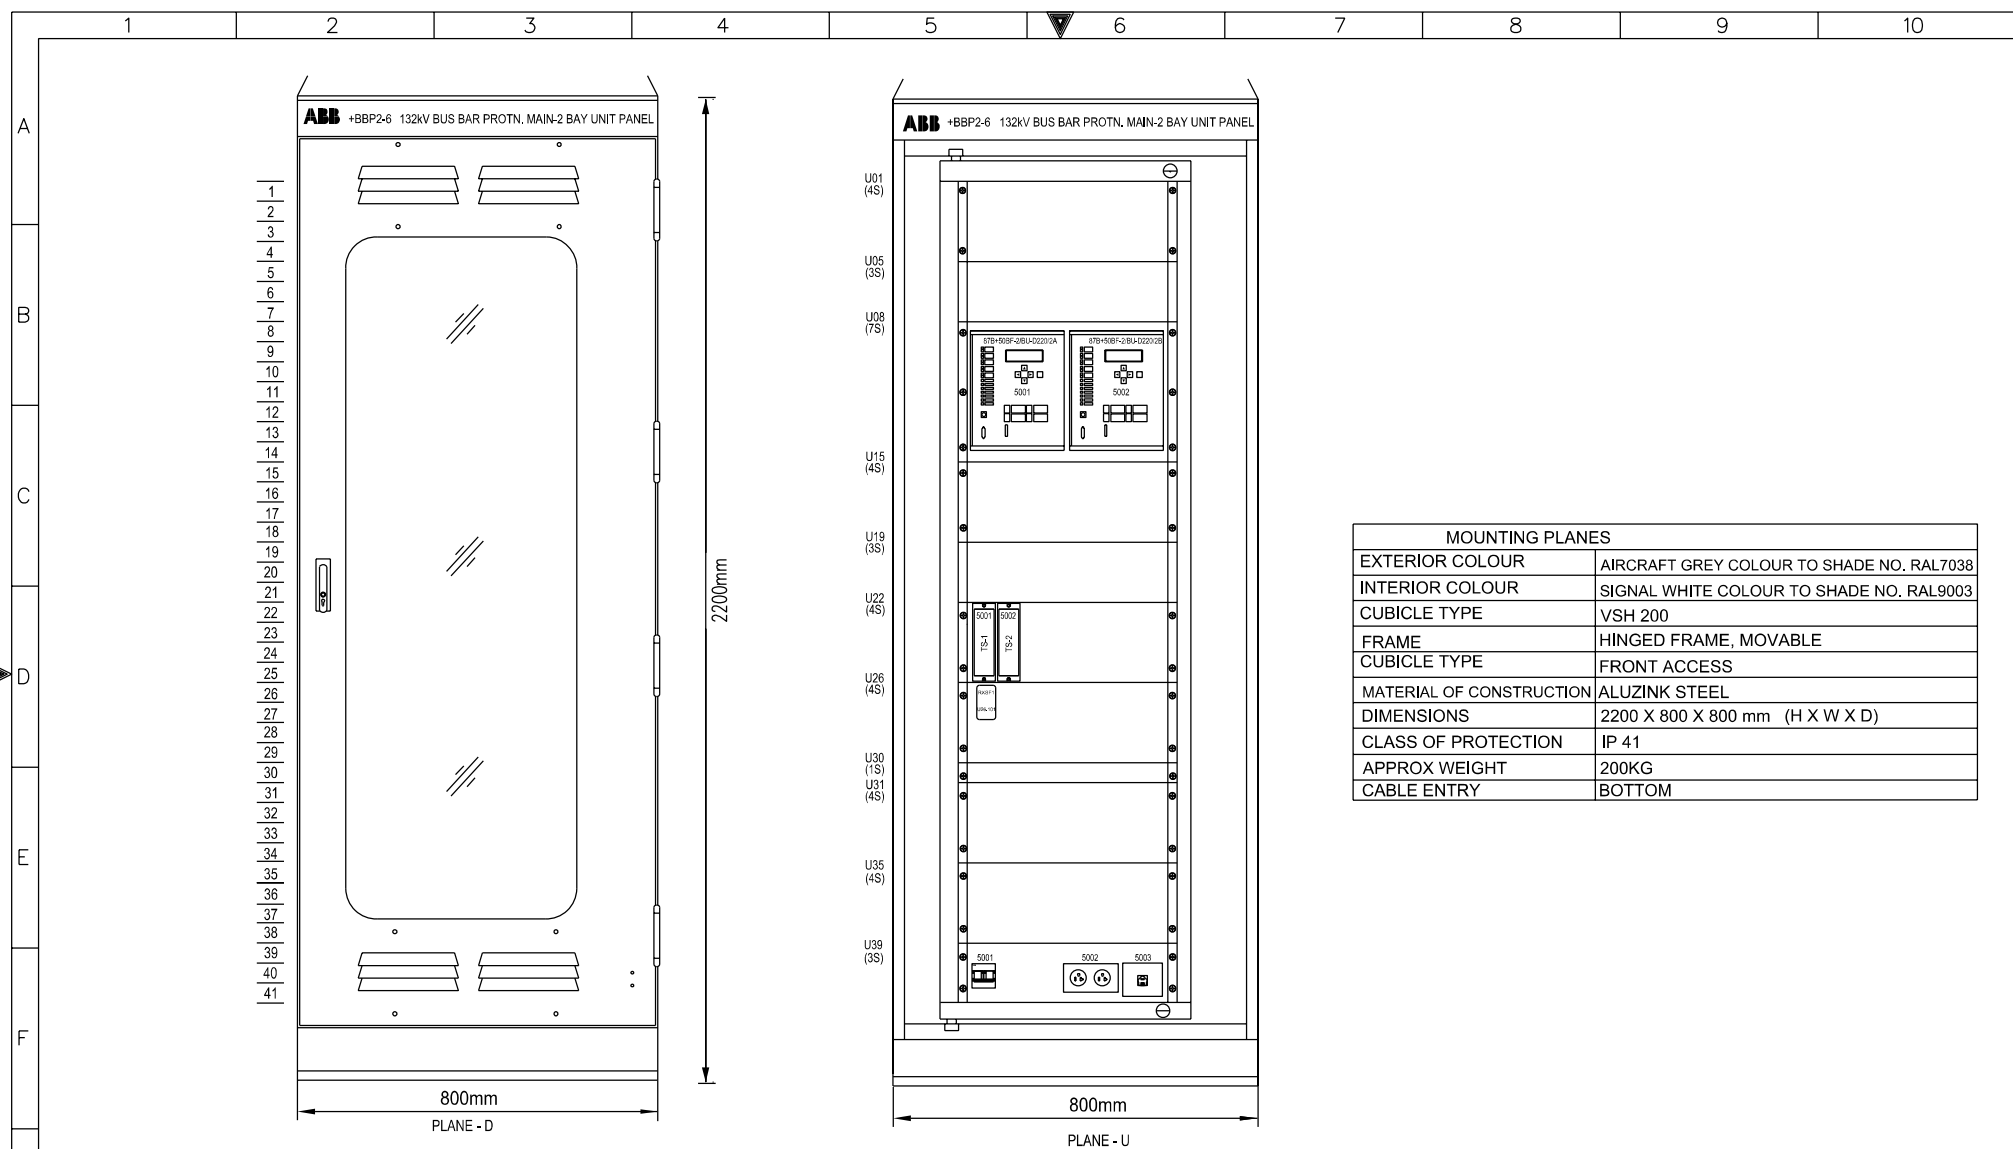


MOUNTING PLANES	
EXTERIOR COLOUR	AIRCRAFT GREY COLOUR TO SHADE NO. RAL7038
INTERIOR COLOUR	SIGNAL WHITE COLOUR TO SHADE NO. RAL9003
CUBICLE TYPE	VSH 200
FRAME	HINGED FRAME, MOVABLE
CUBICLE TYPE	FRONT ACCESS
MATERIAL OF CONSTRUCTION	ALUZINK STEEL
DIMENSIONS	2200 X 800 X 800 mm (H X W X D)
CLASS OF PROTECTION	IP 41
APPROX WEIGHT	200KG
CABLE ENTRY	BOTTOM

G


AS-BUILT BY _____ DATE _____			CONTRACT NO. 11131113/00		JOB ORDER NO. S-13656		ASSEMBLY DRAWING				<div>نقل الكهرباء</div> <div>الشركة الوطنية لنقل الكهرباء</div> <div></div> <div>National Grid SA</div>				
01	13 49	FACTORY ASBUILT FOR APPROVAL	DRAWN BY RIZ			CHECKED BY KVR			132KV BUSBAR PROTN.MAIN-2 BU PANEL +BBP2-6						
00	13 14		DATE STARTED 1.04.2013			DATE COMPLETED _____			S/S 8709			S-13656			
REV. NO.	DATE	DESCRIPTION	OPRG. DEPT. CTPD			ENG. DEPT. AUT-PSAC			RIYADH			SAUDI ARABIA			

INDEX	PLANT NO.	DRAWING NUMBER	SHEET NO.	REV. NO.
-	C421	CD-323015	SHT CONT G01 G02	01

BASE PLATE/
FOUNDATION

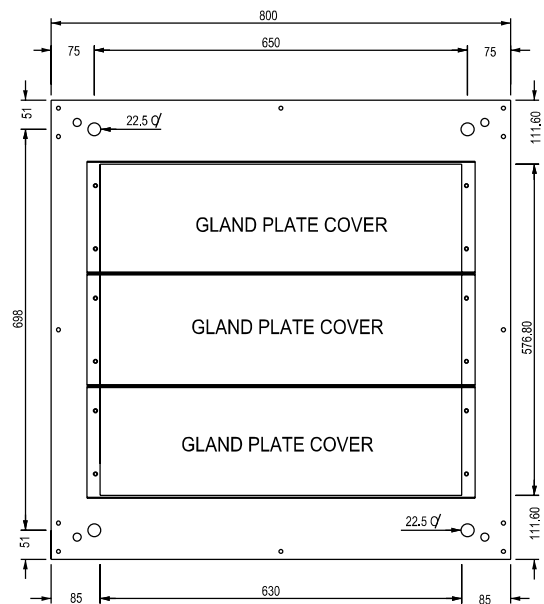

PLAN

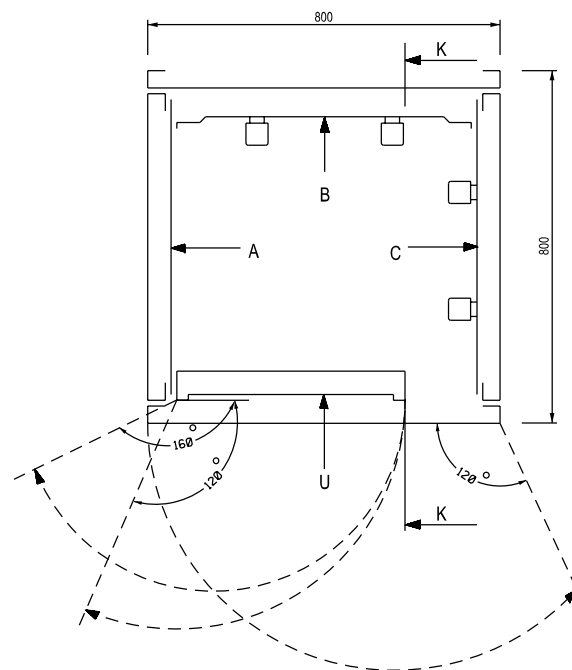

AS-BUILT BY _____ DATE _____ CONTRACT NO. 11131113/00 JOB ORDER NO. S-13656

01	13 49	FACTORY ASBUILT	DRAWN BY RIZ CHECKED BY KVR
00	13 14	FOR APPROVAL	DATE STARTED 11.04.2013 DATE COMPLETED _____
REV. NO.	DATE	DESCRIPTION	OPRG. DEPT. CTPD ENG. DEPT. AUT-PSAC

ASSEMBLY DRAWING

132KV BUSBAR PROTN.MAIN-2 BU PANEL +BBP2-6
S/S 8709 S-13656
RIYADH SAUDI ARABIA

الشركة الوطنية لنقل الكهرباء




INDEX	PLANT NO.	DRAWING NUMBER	SHEET NO.	REV. NO.
-	C421	CD-323015	SHT 1 CONT. G03 G04	01

NG/D2-D (2012/01)
DMS VECTOR NGD200



U PLANE TOP LABEL

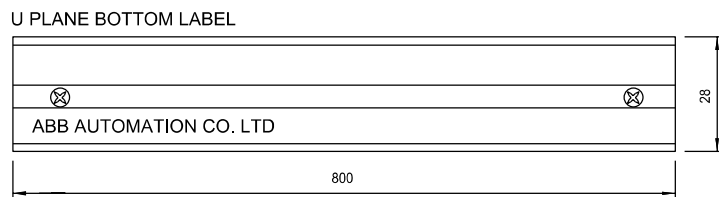

MANUFACTURING LABEL



ABB Automation Co.Ltd.

PROJECT :	National Grid SA	S/S 8709
ORDER REFERENCE :	2875 RF S13656	
YEAR OF MANUFACTURE :	2013	
PANEL NO. :	BBP2-6	
DRAWING NO. :	S13656-CD-323016	

MADE IN THE KINGDOM OF SAUDI ARABIA

AS-BUILT BY _____ DATE _____	CONTRACT NO. 11131113/00	JOB ORDER NO. S-13656
------------------------------	--------------------------	-----------------------

			DRAWN BY <u>RIZ</u> CHECKED BY <u>KVR</u>
01	13 49	FACTORY ASBUILT	DATE STARTED <u>1.04.2013</u> DATE COMPLETED _____
00	13 14	FOR APPROVAL	
REV. NO.	DATE	DESCRIPTION	OPRG. DEPT. <u>CTPD</u> ENG. DEPT. <u>AUT-PSAC</u>

ASSEMBLY DRAWING

132KV BUSBAR PROTN.MAIN-2 BU PANEL +BBP2-6
--

S/S 8709

S-13656

RIYADH

SAUDI ARABIA

الشركة الوطنية لنقل الكهرباء



نقل الكهرباء
National Grid SA

INDEX	PLANT NO.	DRAWING NUMBER	SHEET NO.		REV. NO.
-	C421	CD-323015	SHT	CONT.	01
			G04	L00	

NG/D2-D (2012/01)

DMS

VECTOR

NGD200

THIS DRAWING AND THE INFORMATION CONTAINED HEREIN ARE THE SOLE PROPERTY OF National Grid SA. NO REPRODUCTION IN FULL OR IN PART SHALL BE OBTAINED FROM THIS DOCUMENT WITHOUT THE WRITTEN CONSENT OF ITS OWNER.



POWER SYSTEMS NETWORK MANAGEMENT
PROTECTION AND SUBSTATION AUTOMATION SYSTEMS
WBS NO: S-13656

ABB AUTOMATION COMPANY LTD
414, AL-KHARJ ROAD
SECOND INDUSTRIAL CITY
RIYADH-11383 K.S.A

CLIENT : SAUDI ELECTRICITY COMPANY CENTRAL OPERATING AREA
CONTRACTOR : ABB Contracting Co
PROJECT : CONSTRUCTION OF NEW 132/13.8kV SS 8709 IN AL-KHARJ CITY
SUBSTATION : S/S 8709
CONTRACT NO. : 11131113/00
TITLE : LIST OF APPARATUS - +BBP2-6
[132KV BUSBAR PROTECTION MAIN-2 BAY UNIT PANEL]

AS-BUILT BY _____ DATE _____ CONTRACT NO. 11131113/00 JOB ORDER NO. S-13656

01	13 49	FACTORY ASBUILT	DRAWN BY RIZ	CHECKED BY KVR
00	13 14	FOR APPROVAL	DATE STARTED 11.04.2013	DATE COMPLETED
REV. NO.	DATE	DESCRIPTION	OPRG. DEPT. CTPD	ENG. DEPT. AUT-PSAC

COVER SHEET

32KV BUSBAR PROTN.MAIN-2 BU PANEL +BBP2-6
S/S 8709 S-13656
RIYADH SAUDI ARABIA

الشركة الوطنية لنقل الكهرباء



INDEX	PLANT NO.	DRAWING NUMBER	SHEET NO.	REV. NO.
-	C421	CD-323015	L00L01	01

NG/D2-D (2012/01)
DMS VECTOR NGD200

	1	2	3	4	5	6	7	8	9	10
A	SR. NO.	GA. REF.	SCH. REF.	DESCRIPTION		SHT.	QTY.	TYPE	MAKE	ORDERING INFORMATION
	1	U08.5001	87B+50BF-2/BU-D220/2A	RELAY CUBICLE- +BBP2-6 FOR 132KV BB/BF MAIN-2 ACCOMODATING THE FOLLOWING			2	VSH 200	ABB	
		U08.5002	87B+50BF-2/BU-D220/2B	BAY UNIT FOR NUMERICAL BUSBAR PROTECTION WITH FOLLOWING		293,294		7SS523	SIEMENS	7SS5231-5CA01-1AA1/GG
				HIGH TROUGH-FAULT STABILITY EVEN IN CASE OF CT SATURATION.		295,296				
				NEUTRAL CURRENT CRITERION INSTANTANEOUS VALUES FOR FAULT RECORDING.						
				DISTURBANCE FREE AND FAST DATA TRANSFER TO & FROM CENTRAL UNIT						
				PHASE SEGRAGATED MEASUREMENT						
				REDUCE CT PERFORMANCE REQUIREMENTS						
				BUILT IN HUMAN MACHINE INTERFACE						
				BUILT IN BREAKER FAILURE FUNCTION.						
B				END FAULT PROTECTION FUNCTION						
				DISTURBANCE RECORDER						
				BINARY OUTPUT : 20						
				BINARY OUTPUT : 6+2-WD						
				FULLY NUMERICAL SIGNAL PROCESSING						
				RATED CURRENT : 1A						
				AUX. VOLTAGE : 60-250V DC						
				RATED FREQUENCY : 60HZ						
C	2	U22.101	TS-1	TEST SWITCH FOR 87B+50BF-2/BU-D220/2A RELAY		293	2	MMLG02	ALSTOM	MMLG02 R1AA 0001D
		U22.102	TS-2	TEST SWITCH FOR 87B+50BF-2/BU-D220/2B RELAY		295				
D	3	U26.101	74BF-2/BU-D220	DUAL TARGET RELAY FOR 87B+50BF-2/D220		235	1	RXSF 1	ABB	RK 271 019-AN
				AUXILIARY VOLTAGE : 110-125V DC						
				CONTACT DATA : 1NO + 2NC						
				FLAG : SELF RESET,REVERSE						
E										
F										
G	AS-BUILT BY _____ DATE _____		CONTRACT NO. 11131113/00		JOB ORDER NO. S-13656		LIST OF APPARATUS			
	01	13 49	FACTORY ASBUILT		DRAWN BY RIZ CHECKED BY KVR		132KV BUSBAR PROTN.MAIN-2 BU PANEL +BBP2-6			
	00	13 14	FOR APPROVAL		DATE STARTED 11.04.2013 DATE COMPLETED _____		S/S 8709 S-13656			
	REV. NO.	DATE	DESCRIPTION		OPRG. DEPT. CTPD ENG. DEPT. AUT-PSAC		RIYADH SAUDI ARABIA			
						الشركة الوطنية لنقل الكهرباء				
						National Grid sa				
						INDEX PLANT NO. DRAWING NUMBER SHEET NO. REV. NO.				
						- C421 CD-323015 L01 L02 01				
						NG/D2-D (2012/01)				
						DMS VECTOR NGD200				

	1	2	3	4	5	6	7	8	9	10
A										
B										
C										
D										
E										
F										
G										

SR. NO.	ITEM DESIGNATION	DESCRIPTION	SHEET.NO.	QTY.	TYPE	MAKE	ORDERING INFORMATION		
13	1X1	BOLT CONNECTING TERMINAL BLOCKS FOR DISCONNECTABLE CT CIRCUITS	301	20	OTTA 6T P/P	PHOENIX	0790462		
	X3	SPRING LOADED TERMINAL BLOCKS FOR DISCONNECTABLE AC CIRCUITS		10	D6/8.ST1.RS	ENTRELEC	1SNA 115 831 R0400		
	X4	SPRING LOADED TERMINAL BLOCK FOR DISCONNECTABLE DC EXT. CIRCUITS		10	D6/8.ST1.RS	ENTRELEC	1SNA 115 831 R0400		
	X51	SPRING LOADED TERMINAL BLOCK FOR DC PROTN. CIRCUITS-BU-D220		50	M6/8.RS	ENTRELEC	1SNA 115 688 R2500		
	X6	SPRING LOADED TERMINAL BLOCK FOR ALARM CIRCUITS		5	M6/8.RS	ENTRELEC	1SNA 115 688 R2500		
	X61	KNIFE TYPE TERMINAL BLOCKS FOR COMMON ALARM CIRCUITS		10	M6/8.SNB	ENTRELEC	1SNA 115 685 R1200		
	XTJ	SPRING LOADED TERMINAL BLOCKS FOR TELEPHONE JACK		5	M6/8.RS	ENTRELEC	1SNA 115 688 R2500		
	XSH	SPRING LOADED TERMINAL BLOCKS FOR SPACE HEATER		3	M6/8.RS	ENTRELEC	1SNA 115 688 R2500		
AS-BUILT BY _____ DATE _____ CONTRACT NO. 11131113/00 JOB ORDER NO. S-13656			LIST OF APPARATUS		الشركة الوطنية لنقل الكهرباء National Grid sa				
01	13 49	FACTORY ASBUILT	DRAWN BY RIZ CHECKED BY KVR		132KV BUSBAR PROTN.MAIN-2 BU PANEL +BBP2-6				
00	13 14	FOR APPROVAL	DATE STARTED 1.04.2013 DATE COMPLETED _____		S/S 8709 S-13656				
REV. NO.	DATE	DESCRIPTION	OPRG. DEPT. CTPD ENG. DEPT. AUT-PSAC		RIYADH SAUDI ARABIA				
					INDEX	PLANT NO.	DRAWING NUMBER	SHEET NO.	REV. NO.
					-	C421	CD-323015	L03 L04	01

NG/D2-D (2012/01)
DMS VECTOR NGD200

THIS DRAWING AND THE INFORMATION CONTAINED HEREIN ARE THE SOLE PROPERTY OF NATIONAL GRID SA. NO REPRODUCTION IN FULL OR IN PART SHALL BE OBTAINED FROM THIS DOCUMENT WITHOUT THE WRITTEN CONSENT OF ITS OWNER.

	1	2	3	4	5	6	7	8	9	10																																														
A																																																								
B																																																								
C																																																								
D																																																								
E																																																								
F																																																								
G	<table><tr><td colspan="2">AS-BUILT BY _____ DATE _____</td><td>CONTRACT NO. 11131113/00</td><td>JOB ORDER NO. S-13656</td><td colspan="2">LIST OF APPARATUS</td><td colspan="4"><div>الشركة الوطنية لنقل الكهرباء</div><div> نقل الكهرباء National Grid sa</div></td></tr><tr><td>01</td><td>13 49</td><td>FACTORY ASBUILT</td><td>DRAWN BY RIZ</td><td>CHECKED BY KVR</td><td colspan="2">132KV BUSBAR PROTN,MAIN-2 BU PANEL +BBP2-6</td><td>INDEX</td><td>PLANT NO.</td><td>DRAWING NUMBER</td><td>SHEET NO.</td><td>REV. NO.</td></tr><tr><td>00</td><td>13 14</td><td>FOR APPROVAL</td><td colspan="2">DATE STARTED 11.04.2013 DATE COMPLETED _____</td><td colspan="2">S/S 8709 S-13656</td><td></td><td></td><td></td><td>SHT CONT.</td><td></td></tr><tr><td>REV. NO.</td><td>DATE</td><td>DESCRIPTION</td><td colspan="2">OPRG. DEPT. CTPD ENG. DEPT. AUT-PSAC</td><td colspan="2">RIYADH SAUDI ARABIA</td><td>-</td><td>C421</td><td>CD-323015</td><td>L04 L05</td><td>01</td></tr></table>										AS-BUILT BY _____ DATE _____		CONTRACT NO. 11131113/00	JOB ORDER NO. S-13656	LIST OF APPARATUS		<div>الشركة الوطنية لنقل الكهرباء</div> <div> نقل الكهرباء National Grid sa</div>				01	13 49	FACTORY ASBUILT	DRAWN BY RIZ	CHECKED BY KVR	132KV BUSBAR PROTN,MAIN-2 BU PANEL +BBP2-6		INDEX	PLANT NO.	DRAWING NUMBER	SHEET NO.	REV. NO.	00	13 14	FOR APPROVAL	DATE STARTED 11.04.2013 DATE COMPLETED _____		S/S 8709 S-13656					SHT CONT.		REV. NO.	DATE	DESCRIPTION	OPRG. DEPT. CTPD ENG. DEPT. AUT-PSAC		RIYADH SAUDI ARABIA		-	C421	CD-323015	L04 L05	01
AS-BUILT BY _____ DATE _____		CONTRACT NO. 11131113/00	JOB ORDER NO. S-13656	LIST OF APPARATUS		<div>الشركة الوطنية لنقل الكهرباء</div> <div> نقل الكهرباء National Grid sa</div>																																																		
01	13 49	FACTORY ASBUILT	DRAWN BY RIZ	CHECKED BY KVR	132KV BUSBAR PROTN,MAIN-2 BU PANEL +BBP2-6		INDEX	PLANT NO.	DRAWING NUMBER	SHEET NO.	REV. NO.																																													
00	13 14	FOR APPROVAL	DATE STARTED 11.04.2013 DATE COMPLETED _____		S/S 8709 S-13656					SHT CONT.																																														
REV. NO.	DATE	DESCRIPTION	OPRG. DEPT. CTPD ENG. DEPT. AUT-PSAC		RIYADH SAUDI ARABIA		-	C421	CD-323015	L04 L05	01																																													

THIS DRAWING AND THE INFORMATION CONTAINED HEREIN ARE THE SOLE PROPERTY OF NATIONAL GRID SA. NO REPRODUCTION IN FULL OR IN PART SHALL BE OBTAINED FROM THIS DOCUMENT WITHOUT THE WRITTEN CONSENT OF ITS OWNER.

	1	2	3	4	5	6	7	8	9	10																																																									
A																																																																			
B																																																																			
C																																																																			
D																																																																			
E																																																																			
F																																																																			
G	<table><tr><td colspan="3">AS-BUILT BY _____ DATE _____</td><td colspan="2">CONTRACT NO. 11131113/00</td><td colspan="2">JOB ORDER NO. S-13656</td><td colspan="3">LIST OF APPARATUS</td><td colspan="2"><div>الشركة الوطنية لنقل الكهرباء</div><div> نقل الكهرباء National Grid sa</div></td></tr><tr><td>01</td><td>13 49</td><td colspan="3">FACTORY ASBUILT</td><td colspan="2">DRAWN BY RIZ CHECKED BY KVR</td><td colspan="3">132KV BUSBAR PROTN.MAIN-2 BU PANEL +BBP2-6</td><td>INDEX</td><td>PLANT NO.</td><td>DRAWING NUMBER</td><td>SHEET NO.</td><td>REV. NO.</td></tr><tr><td>00</td><td>13 14</td><td colspan="3">FOR APPROVAL</td><td colspan="2">DATE STARTED 11.04.2013 DATE COMPLETED _____</td><td colspan="3">S/S 8709 S-13656</td><td>-</td><td>C421</td><td>CD-323015</td><td>SHT CONT </td><td></td></tr><tr><td>REV. NO.</td><td>DATE</td><td colspan="3">DESCRIPTION</td><td colspan="2">OPRG. DEPT. CTPD ENG. DEPT. AUT-PSAC</td><td colspan="3">RIYADH SAUDI ARABIA</td><td></td><td></td><td></td><td>L05 000</td><td>01</td></tr></table>										AS-BUILT BY _____ DATE _____			CONTRACT NO. 11131113/00		JOB ORDER NO. S-13656		LIST OF APPARATUS			<div>الشركة الوطنية لنقل الكهرباء</div> <div> نقل الكهرباء National Grid sa</div>		01	13 49	FACTORY ASBUILT			DRAWN BY RIZ CHECKED BY KVR		132KV BUSBAR PROTN.MAIN-2 BU PANEL +BBP2-6			INDEX	PLANT NO.	DRAWING NUMBER	SHEET NO.	REV. NO.	00	13 14	FOR APPROVAL			DATE STARTED 11.04.2013 DATE COMPLETED _____		S/S 8709 S-13656			-	C421	CD-323015	SHT CONT		REV. NO.	DATE	DESCRIPTION			OPRG. DEPT. CTPD ENG. DEPT. AUT-PSAC		RIYADH SAUDI ARABIA						L05 000	01
AS-BUILT BY _____ DATE _____			CONTRACT NO. 11131113/00		JOB ORDER NO. S-13656		LIST OF APPARATUS			<div>الشركة الوطنية لنقل الكهرباء</div> <div> نقل الكهرباء National Grid sa</div>																																																									
01	13 49	FACTORY ASBUILT			DRAWN BY RIZ CHECKED BY KVR		132KV BUSBAR PROTN.MAIN-2 BU PANEL +BBP2-6			INDEX	PLANT NO.	DRAWING NUMBER	SHEET NO.	REV. NO.																																																					
00	13 14	FOR APPROVAL			DATE STARTED 11.04.2013 DATE COMPLETED _____		S/S 8709 S-13656			-	C421	CD-323015	SHT CONT																																																						
REV. NO.	DATE	DESCRIPTION			OPRG. DEPT. CTPD ENG. DEPT. AUT-PSAC		RIYADH SAUDI ARABIA						L05 000	01																																																					



POWER SYSTEMS NETWORK MANAGEMENT
PROTECTION AND SUBSTATION AUTOMATION SYSTEMS
WBS NO: S-13656

ABB AUTOMATION COMPANY LTD.
414, AL-KHARJ ROAD
SECOND INDUSTRIAL CITY
RIYADH-11383 K.S.A

CLIENT : SAUDI ELECTRICITY COMPANY CENTRAL OPERATING AREA
CONTRACTOR : ABB Contracting Co
PROJECT : CONSTRUCTION OF NEW 132/13.8kV SS 8709 IN AL-KHARJ CITY
SUBSTATION : S/S 8709
CONTRACT NO. : 11131113/00
TITLE : SCHEMATICS DRAWINGS - +BBP2-6
[132KV BUSBAR PROTECTION MAIN-2 BAY UNIT PANEL]

AS-BUILT BY _____ DATE _____ CONTRACT NO. 11131113/00 JOB ORDER NO. S-13656

01	13 49	FACTORY ASBUILT	DRAWN BY RIZ	CHECKED BY KVR
00	13 14	FOR APPROVAL	DATE STARTED 11.04.2013	DATE COMPLETED
REV. NO.	DATE	DESCRIPTION	OPRG. DEPT. CTPD	ENG. DEPT. AUT-PSAC

COVER SHEET

132KV BUSBAR PROTN.MAIN-2 BU PANEL +BBP2-6
S/S 8709 S-13656
RIYADH SAUDI ARABIA

الشركة الوطنية لنقل الكهرباء



نقل الكهرباء
National Grid sa

INDEX	PLANT NO.	DRAWING NUMBER	SHEET NO.	REV. NO.
-	C421	CD-323016	SHT 001	01

NG/D2-D (2012/01)

DMS

VECTOR

NGD200

	1	2	3	4	5	6	7	8	9	10																																																																																																																																							
A	<table><tr><th>CONTENTS</th><th>ABB SHT.NO.</th><th>REV.00</th><th>REV.01</th><th>REV.02</th></tr><tr><td>COVER SHEET</td><td>000</td><td>X</td><td>X</td><td></td></tr><tr><td>CONTENTS SHEET</td><td>001</td><td>X</td><td>X</td><td></td></tr><tr><td>GRAPHICAL SYMBOLS FOR DIAGRAMS</td><td>011</td><td>X</td><td>X</td><td></td></tr><tr><td>GRAPHICAL SYMBOLS FOR DIAGRAMS</td><td>012</td><td>X</td><td>X</td><td></td></tr><tr><td>COMMON LEGEND</td><td>013</td><td>X</td><td>X</td><td></td></tr><tr><td>FERRULE AND WIRING DETAILS</td><td>014</td><td>X</td><td>X</td><td></td></tr><tr><td>DRAWING REFERENCES</td><td>015</td><td>X</td><td>X</td><td></td></tr><tr><td>DRAWING REFERENCES</td><td>016</td><td>X</td><td>X</td><td></td></tr><tr><td>PRIMARY SYSTEM</td><td>051</td><td>X</td><td>X</td><td></td></tr><tr><td>AC SUPPLY FOR ILLUMINATION & POWER SOCKET</td><td>211</td><td>X</td><td>X</td><td></td></tr><tr><td>CUB. LIGHTING, HEATER & SOCKET ALARM CKT.</td><td>212</td><td>X</td><td>X</td><td></td></tr><tr><td>DC SUPPLY DISTRIBUTION</td><td>216</td><td>X</td><td>X</td><td></td></tr><tr><td>CURRENT TRANSFORMER INPUTS -87B+50BF-2/BU-D220/2A</td><td>221</td><td>X</td><td>X</td><td></td></tr><tr><td>CURRENT TRANSFORMER INPUTS -87B+50BF-2/BU-D220/2B</td><td>222</td><td>X</td><td>X</td><td></td></tr><tr><td>87B+50BF-2/BU-D220/2A PROTN.RELAY-BINARY INPUTS</td><td>231</td><td>X</td><td>X</td><td></td></tr><tr><td>87B+50BF-2/BU-D220/2A PROTN.RELAY-BINARY INPUTS</td><td>232</td><td>X</td><td>X</td><td></td></tr><tr><td>87B+50BF-2/BU-D220/2B PROTN.RELAY-BINARY INPUTS</td><td>234</td><td>X</td><td>X</td><td></td></tr><tr><td>87B+50BF-2/BU-D220/2B PROTN.RELAY-BINARY INPUTS</td><td>235</td><td>X</td><td>X</td><td></td></tr><tr><td>COMMON ALARM CIRCUITS</td><td>292</td><td>X</td><td>X</td><td></td></tr><tr><td>BLOCK REFERENCE 87B+50BF-2/BU-D220/2A</td><td>293</td><td>X</td><td>X</td><td></td></tr><tr><td>BLOCK REFERENCE 87B+50BF-2/BU-D220/2A</td><td>294</td><td>X</td><td>X</td><td></td></tr><tr><td>BLOCK REFERENCE 87B+50BF-2/BU-D220/2B</td><td>295</td><td>X</td><td>X</td><td></td></tr><tr><td>BLOCK REFERENCE 87B+50BF-2/BU-D220/2B</td><td>296</td><td>X</td><td>X</td><td></td></tr><tr><td>TERMINAL BLOCKS REFERENCE</td><td>301</td><td>X</td><td>X</td><td></td></tr><tr><td></td><td></td><td></td><td></td><td></td></tr><tr><td></td><td></td><td></td><td></td><td></td></tr></table>					CONTENTS	ABB SHT.NO.	REV.00	REV.01	REV.02	COVER SHEET	000	X	X		CONTENTS SHEET	001	X	X		GRAPHICAL SYMBOLS FOR DIAGRAMS	011	X	X		GRAPHICAL SYMBOLS FOR DIAGRAMS	012	X	X		COMMON LEGEND	013	X	X		FERRULE AND WIRING DETAILS	014	X	X		DRAWING REFERENCES	015	X	X		DRAWING REFERENCES	016	X	X		PRIMARY SYSTEM	051	X	X		AC SUPPLY FOR ILLUMINATION & POWER SOCKET	211	X	X		CUB. LIGHTING, HEATER & SOCKET ALARM CKT.	212	X	X		DC SUPPLY DISTRIBUTION	216	X	X		CURRENT TRANSFORMER INPUTS -87B+50BF-2/BU-D220/2A	221	X	X		CURRENT TRANSFORMER INPUTS -87B+50BF-2/BU-D220/2B	222	X	X		87B+50BF-2/BU-D220/2A PROTN.RELAY-BINARY INPUTS	231	X	X		87B+50BF-2/BU-D220/2A PROTN.RELAY-BINARY INPUTS	232	X	X		87B+50BF-2/BU-D220/2B PROTN.RELAY-BINARY INPUTS	234	X	X		87B+50BF-2/BU-D220/2B PROTN.RELAY-BINARY INPUTS	235	X	X		COMMON ALARM CIRCUITS	292	X	X		BLOCK REFERENCE 87B+50BF-2/BU-D220/2A	293	X	X		BLOCK REFERENCE 87B+50BF-2/BU-D220/2A	294	X	X		BLOCK REFERENCE 87B+50BF-2/BU-D220/2B	295	X	X		BLOCK REFERENCE 87B+50BF-2/BU-D220/2B	296	X	X		TERMINAL BLOCKS REFERENCE	301	X	X																
CONTENTS						ABB SHT.NO.	REV.00	REV.01	REV.02																																																																																																																																								
COVER SHEET						000	X	X																																																																																																																																									
CONTENTS SHEET						001	X	X																																																																																																																																									
GRAPHICAL SYMBOLS FOR DIAGRAMS						011	X	X																																																																																																																																									
GRAPHICAL SYMBOLS FOR DIAGRAMS						012	X	X																																																																																																																																									
COMMON LEGEND						013	X	X																																																																																																																																									
FERRULE AND WIRING DETAILS						014	X	X																																																																																																																																									
DRAWING REFERENCES						015	X	X																																																																																																																																									
DRAWING REFERENCES						016	X	X																																																																																																																																									
PRIMARY SYSTEM						051	X	X																																																																																																																																									
AC SUPPLY FOR ILLUMINATION & POWER SOCKET						211	X	X																																																																																																																																									
CUB. LIGHTING, HEATER & SOCKET ALARM CKT.						212	X	X																																																																																																																																									
DC SUPPLY DISTRIBUTION						216	X	X																																																																																																																																									
CURRENT TRANSFORMER INPUTS -87B+50BF-2/BU-D220/2A						221	X	X																																																																																																																																									
CURRENT TRANSFORMER INPUTS -87B+50BF-2/BU-D220/2B						222	X	X																																																																																																																																									
87B+50BF-2/BU-D220/2A PROTN.RELAY-BINARY INPUTS						231	X	X																																																																																																																																									
87B+50BF-2/BU-D220/2A PROTN.RELAY-BINARY INPUTS						232	X	X																																																																																																																																									
87B+50BF-2/BU-D220/2B PROTN.RELAY-BINARY INPUTS						234	X	X																																																																																																																																									
87B+50BF-2/BU-D220/2B PROTN.RELAY-BINARY INPUTS						235	X	X																																																																																																																																									
COMMON ALARM CIRCUITS	292	X	X																																																																																																																																														
BLOCK REFERENCE 87B+50BF-2/BU-D220/2A	293	X	X																																																																																																																																														
BLOCK REFERENCE 87B+50BF-2/BU-D220/2A	294	X	X																																																																																																																																														
BLOCK REFERENCE 87B+50BF-2/BU-D220/2B	295	X	X																																																																																																																																														
BLOCK REFERENCE 87B+50BF-2/BU-D220/2B	296	X	X																																																																																																																																														
TERMINAL BLOCKS REFERENCE	301	X	X																																																																																																																																														
B																																																																																																																																																	
C																																																																																																																																																	
D																																																																																																																																																	
E																																																																																																																																																	
F																																																																																																																																																	
G	<table><tr><td colspan="2">AS-BUILT BY _____ DATE _____</td><td>CONTRACT NO. 11131113/00</td><td colspan="2">JOB ORDER NO. S-13656</td></tr><tr><td>01</td><td>13 49</td><td colspan="2">FACTORY ASBUILT</td><td>DRAWN BY RIZ CHECKED BY KVR</td></tr><tr><td>00</td><td>13 14</td><td colspan="2">FOR APPROVAL</td><td>DATE STARTED 11.04.2013 DATE COMPLETED _____</td></tr><tr><td>REV. NO.</td><td>DATE</td><td colspan="2">DESCRIPTION</td><td>OPRG. DEPT. CTPD ENG. DEPT. AUT-PSAC</td></tr></table>					AS-BUILT BY _____ DATE _____		CONTRACT NO. 11131113/00	JOB ORDER NO. S-13656		01	13 49	FACTORY ASBUILT		DRAWN BY RIZ CHECKED BY KVR	00	13 14	FOR APPROVAL		DATE STARTED 11.04.2013 DATE COMPLETED _____	REV. NO.	DATE	DESCRIPTION		OPRG. DEPT. CTPD ENG. DEPT. AUT-PSAC	<table><tr><td colspan="2">CONTENTS SHEET</td></tr><tr><td colspan="2">32KV BUSBAR PROTN.MAIN-2 BU PANEL +BBP2-6</td></tr><tr><td>S/S 8709</td><td>S-13656</td></tr><tr><td>RIYADH</td><td>SAUDI ARABIA</td></tr></table>					CONTENTS SHEET		32KV BUSBAR PROTN.MAIN-2 BU PANEL +BBP2-6		S/S 8709	S-13656	RIYADH	SAUDI ARABIA	<table><tr><td colspan="2">الشركة الوطنية لنقل الكهرباء</td><td colspan="2">National Grid sa</td></tr><tr><td>INDEX</td><td>PLANT NO.</td><td>DRAWING NUMBER</td><td>SHEET NO.</td><td>REV. NO.</td></tr><tr><td>-</td><td>C421</td><td>CD-323016</td><td>SHT 001 CONT. 011</td><td>01</td></tr></table>					الشركة الوطنية لنقل الكهرباء		National Grid sa		INDEX	PLANT NO.	DRAWING NUMBER	SHEET NO.	REV. NO.	-	C421	CD-323016	SHT 001 CONT. 011	01																																																																																								
AS-BUILT BY _____ DATE _____		CONTRACT NO. 11131113/00	JOB ORDER NO. S-13656																																																																																																																																														
01	13 49	FACTORY ASBUILT		DRAWN BY RIZ CHECKED BY KVR																																																																																																																																													
00	13 14	FOR APPROVAL		DATE STARTED 11.04.2013 DATE COMPLETED _____																																																																																																																																													
REV. NO.	DATE	DESCRIPTION		OPRG. DEPT. CTPD ENG. DEPT. AUT-PSAC																																																																																																																																													
CONTENTS SHEET																																																																																																																																																	
32KV BUSBAR PROTN.MAIN-2 BU PANEL +BBP2-6																																																																																																																																																	
S/S 8709	S-13656																																																																																																																																																
RIYADH	SAUDI ARABIA																																																																																																																																																
الشركة الوطنية لنقل الكهرباء		National Grid sa																																																																																																																																															
INDEX	PLANT NO.	DRAWING NUMBER	SHEET NO.	REV. NO.																																																																																																																																													
-	C421	CD-323016	SHT 001 CONT. 011	01																																																																																																																																													

	1	2	3	4	5	6	7	8	9	10																																																																																																																		
A																																																																																																																												
B																																																																																																																												
C																																																																																																																												
D																																																																																																																												
E																																																																																																																												
F																																																																																																																												
	<table><tr><th>SYMBOL</th><th>DESCRIPTION</th><th>SYMBOL</th><th>DESCRIPTION</th><th>SYMBOL</th><th>DESCRIPTION</th></tr><tr><td></td><td>FRAME CONNECTION</td><td></td><td>MAIN CONTACT OF A CIRCUIT BREAKER</td><td></td><td>RELAY WITH TWO MAKE CONTACTS, ONE OF THEM DELAYED WHEN OPERATING</td></tr><tr><td></td><td>EARTH CONNECTION</td><td></td><td>PASSING MAKE CONTACT CLOSING MOMENTARILY DURING OPERATION AND RELEASE</td><td></td><td>RELAY WITH TWO ACTUATORS AND A TWO STABLE POSITIONS</td></tr><tr><td></td><td>RESISTOR</td><td></td><td>BREAK CONTACT DELAYED WHEN OPERATING</td><td></td><td></td></tr><tr><td></td><td>VARIABLE RESISTOR</td><td></td><td>MAKE CONTACT DELAYED WHEN RELEASING</td><td></td><td>SIGNALLING LAMP</td></tr><tr><td></td><td>RESISTOR WITH PRESET ADJUSTMENT</td><td></td><td>TWO MECHANICAL LINKS CROSSING WITHOUT CONNECTION</td><td></td><td>MECHANICAL INDICATOR WITH AUTOMATIC RESET</td></tr><tr><td></td><td>CAPACITOR</td><td></td><td>JUNCTION OF MECHANICAL LINKS</td><td></td><td>MECHANICAL INDICATOR WITH NON-AUTOMATIC RESET</td></tr><tr><td></td><td>SEMICONDUCTOR DIODE USED AS A CAPACITIVE DEVICE</td><td></td><td>AUTOMATIC RESET</td><td></td><td>ELECTRICALLY CONTROLLED MECHANICAL INDICATOR WITH AUTOMATIC RESET</td></tr><tr><td></td><td>OPEN CONTACT, MAKE CONTACT</td><td></td><td>NON-AUTOMATIC RESET</td><td></td><td>ELECTRICALLY CONTROLLED MECHANICAL INDICATOR WITH NON-AUTOMATIC RESET</td></tr><tr><td></td><td>CLOSED CONTACT, BREAK CONTACT</td><td></td><td>SWITCHING DEVICE WITH MANUAL OPERATION AND WITH AUTOMATIC RESET</td><td></td><td>RELAY WITH MAKE CONTACT</td></tr><tr><td></td><td>CHANGE-OVER CONTACT, BREAK BEFORE MAKE</td><td></td><td>SWITCHING DEVICE WITH MANUAL OPERATION AND WITH NON-AUTOMATIC RESET</td><td></td><td>RELAY WITH CHANGE-OVER CONTACT</td></tr><tr><td></td><td>MAKE CONTACT WHICH IS EARLY WHEN OPERATING AND LATE WHEN RELEASING</td><td></td><td>CHANGE-OVER SWITCHING DEVICE WITH MANUAL CONTROL</td><td></td><td>RELAY WITH MAKE CONTACT, DELAYED WHEN OPERATING</td></tr><tr><td></td><td>BREAK CONTACT WHICH IS LATE WHEN OPERATING AND EARLY WHEN RELEASING</td><td></td><td>RELAY WITH MAKE CONTACT, DELAYED WHEN RELEASING</td><td></td><td>RELAY WITH MAKE CONTACT, DELAYED WHEN OPERATING AND RELEASING</td></tr><tr><td></td><td>SWITCHING DEVICE WITH MANUAL CONTROL</td><td></td><td></td><td></td><td></td></tr><tr><td></td><td>MAKE CONTACT DELAYED WHEN OPERATING</td><td></td><td></td><td></td><td></td></tr><tr><td></td><td>BREAK CONTACT DELAYED WHEN RELEASING</td><td></td><td></td><td></td><td></td></tr><tr><td></td><td>MAKE CONTACT DELAYED WHEN OPERATING AND RELEASING</td><td></td><td></td><td></td><td></td></tr><tr><td></td><td>MAIN CONTACT OF A SWITCH DISCONNECTOR</td><td></td><td></td><td></td><td></td></tr><tr><td></td><td>MAIN CONTACT OF A DISCONNECTOR</td><td></td><td></td><td></td><td></td></tr></table>										SYMBOL	DESCRIPTION	SYMBOL	DESCRIPTION	SYMBOL	DESCRIPTION		FRAME CONNECTION		MAIN CONTACT OF A CIRCUIT BREAKER		RELAY WITH TWO MAKE CONTACTS, ONE OF THEM DELAYED WHEN OPERATING		EARTH CONNECTION		PASSING MAKE CONTACT CLOSING MOMENTARILY DURING OPERATION AND RELEASE		RELAY WITH TWO ACTUATORS AND A TWO STABLE POSITIONS		RESISTOR		BREAK CONTACT DELAYED WHEN OPERATING				VARIABLE RESISTOR		MAKE CONTACT DELAYED WHEN RELEASING		SIGNALLING LAMP		RESISTOR WITH PRESET ADJUSTMENT		TWO MECHANICAL LINKS CROSSING WITHOUT CONNECTION		MECHANICAL INDICATOR WITH AUTOMATIC RESET		CAPACITOR		JUNCTION OF MECHANICAL LINKS		MECHANICAL INDICATOR WITH NON-AUTOMATIC RESET		SEMICONDUCTOR DIODE USED AS A CAPACITIVE DEVICE		AUTOMATIC RESET		ELECTRICALLY CONTROLLED MECHANICAL INDICATOR WITH AUTOMATIC RESET		OPEN CONTACT, MAKE CONTACT		NON-AUTOMATIC RESET		ELECTRICALLY CONTROLLED MECHANICAL INDICATOR WITH NON-AUTOMATIC RESET		CLOSED CONTACT, BREAK CONTACT		SWITCHING DEVICE WITH MANUAL OPERATION AND WITH AUTOMATIC RESET		RELAY WITH MAKE CONTACT		CHANGE-OVER CONTACT, BREAK BEFORE MAKE		SWITCHING DEVICE WITH MANUAL OPERATION AND WITH NON-AUTOMATIC RESET		RELAY WITH CHANGE-OVER CONTACT		MAKE CONTACT WHICH IS EARLY WHEN OPERATING AND LATE WHEN RELEASING		CHANGE-OVER SWITCHING DEVICE WITH MANUAL CONTROL		RELAY WITH MAKE CONTACT, DELAYED WHEN OPERATING		BREAK CONTACT WHICH IS LATE WHEN OPERATING AND EARLY WHEN RELEASING		RELAY WITH MAKE CONTACT, DELAYED WHEN RELEASING		RELAY WITH MAKE CONTACT, DELAYED WHEN OPERATING AND RELEASING		SWITCHING DEVICE WITH MANUAL CONTROL						MAKE CONTACT DELAYED WHEN OPERATING						BREAK CONTACT DELAYED WHEN RELEASING						MAKE CONTACT DELAYED WHEN OPERATING AND RELEASING						MAIN CONTACT OF A SWITCH DISCONNECTOR						MAIN CONTACT OF A DISCONNECTOR				
SYMBOL	DESCRIPTION	SYMBOL	DESCRIPTION	SYMBOL	DESCRIPTION																																																																																																																							
	FRAME CONNECTION		MAIN CONTACT OF A CIRCUIT BREAKER		RELAY WITH TWO MAKE CONTACTS, ONE OF THEM DELAYED WHEN OPERATING																																																																																																																							
	EARTH CONNECTION		PASSING MAKE CONTACT CLOSING MOMENTARILY DURING OPERATION AND RELEASE		RELAY WITH TWO ACTUATORS AND A TWO STABLE POSITIONS																																																																																																																							
	RESISTOR		BREAK CONTACT DELAYED WHEN OPERATING																																																																																																																									
	VARIABLE RESISTOR		MAKE CONTACT DELAYED WHEN RELEASING		SIGNALLING LAMP																																																																																																																							
	RESISTOR WITH PRESET ADJUSTMENT		TWO MECHANICAL LINKS CROSSING WITHOUT CONNECTION		MECHANICAL INDICATOR WITH AUTOMATIC RESET																																																																																																																							
	CAPACITOR		JUNCTION OF MECHANICAL LINKS		MECHANICAL INDICATOR WITH NON-AUTOMATIC RESET																																																																																																																							
	SEMICONDUCTOR DIODE USED AS A CAPACITIVE DEVICE		AUTOMATIC RESET		ELECTRICALLY CONTROLLED MECHANICAL INDICATOR WITH AUTOMATIC RESET																																																																																																																							
	OPEN CONTACT, MAKE CONTACT		NON-AUTOMATIC RESET		ELECTRICALLY CONTROLLED MECHANICAL INDICATOR WITH NON-AUTOMATIC RESET																																																																																																																							
	CLOSED CONTACT, BREAK CONTACT		SWITCHING DEVICE WITH MANUAL OPERATION AND WITH AUTOMATIC RESET		RELAY WITH MAKE CONTACT																																																																																																																							
	CHANGE-OVER CONTACT, BREAK BEFORE MAKE		SWITCHING DEVICE WITH MANUAL OPERATION AND WITH NON-AUTOMATIC RESET		RELAY WITH CHANGE-OVER CONTACT																																																																																																																							
	MAKE CONTACT WHICH IS EARLY WHEN OPERATING AND LATE WHEN RELEASING		CHANGE-OVER SWITCHING DEVICE WITH MANUAL CONTROL		RELAY WITH MAKE CONTACT, DELAYED WHEN OPERATING																																																																																																																							
	BREAK CONTACT WHICH IS LATE WHEN OPERATING AND EARLY WHEN RELEASING		RELAY WITH MAKE CONTACT, DELAYED WHEN RELEASING		RELAY WITH MAKE CONTACT, DELAYED WHEN OPERATING AND RELEASING																																																																																																																							
	SWITCHING DEVICE WITH MANUAL CONTROL																																																																																																																											
	MAKE CONTACT DELAYED WHEN OPERATING																																																																																																																											
	BREAK CONTACT DELAYED WHEN RELEASING																																																																																																																											
	MAKE CONTACT DELAYED WHEN OPERATING AND RELEASING																																																																																																																											
	MAIN CONTACT OF A SWITCH DISCONNECTOR																																																																																																																											
	MAIN CONTACT OF A DISCONNECTOR																																																																																																																											
G	<table><tr><td colspan="2">AS-BUILT BY _____ DATE _____</td><td colspan="2">CONTRACT NO. 11131113/00</td><td colspan="2">JOB ORDER NO. S-13656</td><td colspan="2">GRAPHICAL SYMBOLS FOR DIAGRAMS</td><td colspan="2">الشركة الوطنية لنقل الكهرباء</td></tr><tr><td>01</td><td>13 49</td><td colspan="2">FACTORY ASBUILT</td><td>DRAWN BY RIZ</td><td>CHECKED BY KVR</td><td colspan="2">32KV BUSBAR PROTN.MAIN-2 BU PANEL +BBP2-6</td><td colspan="2">National Grid sa</td></tr><tr><td>00</td><td>13 14</td><td colspan="2">FOR APPROVAL</td><td colspan="2">DATE STARTED 11.04.2013 DATE COMPLETED _____</td><td>S/S 8709</td><td>S-13656</td><td>INDEX</td><td>PLANT NO.</td></tr><tr><td>REV. NO.</td><td>DATE</td><td colspan="2">DESCRIPTION</td><td colspan="2">OPRG. DEPT. CTPD ENG. DEPT. AUT-PSAC</td><td>RIYADH</td><td>SAUDI ARABIA</td><td>DRAWING NUMBER</td><td>SHEET NO.</td></tr><tr><td></td><td></td><td colspan="2"></td><td colspan="2"></td><td></td><td></td><td>CD-323016</td><td>SHT CONT.</td></tr><tr><td></td><td></td><td colspan="2"></td><td colspan="2"></td><td></td><td></td><td></td><td>011 012</td></tr><tr><td></td><td></td><td colspan="2"></td><td colspan="2"></td><td></td><td></td><td></td><td>01</td></tr></table>										AS-BUILT BY _____ DATE _____		CONTRACT NO. 11131113/00		JOB ORDER NO. S-13656		GRAPHICAL SYMBOLS FOR DIAGRAMS		الشركة الوطنية لنقل الكهرباء		01	13 49	FACTORY ASBUILT		DRAWN BY RIZ	CHECKED BY KVR	32KV BUSBAR PROTN.MAIN-2 BU PANEL +BBP2-6		National Grid sa		00	13 14	FOR APPROVAL		DATE STARTED 11.04.2013 DATE COMPLETED _____		S/S 8709	S-13656	INDEX	PLANT NO.	REV. NO.	DATE	DESCRIPTION		OPRG. DEPT. CTPD ENG. DEPT. AUT-PSAC		RIYADH	SAUDI ARABIA	DRAWING NUMBER	SHEET NO.									CD-323016	SHT CONT.										011 012										01																																												
AS-BUILT BY _____ DATE _____		CONTRACT NO. 11131113/00		JOB ORDER NO. S-13656		GRAPHICAL SYMBOLS FOR DIAGRAMS		الشركة الوطنية لنقل الكهرباء																																																																																																																				
01	13 49	FACTORY ASBUILT		DRAWN BY RIZ	CHECKED BY KVR	32KV BUSBAR PROTN.MAIN-2 BU PANEL +BBP2-6		National Grid sa																																																																																																																				
00	13 14	FOR APPROVAL		DATE STARTED 11.04.2013 DATE COMPLETED _____		S/S 8709	S-13656	INDEX	PLANT NO.																																																																																																																			
REV. NO.	DATE	DESCRIPTION		OPRG. DEPT. CTPD ENG. DEPT. AUT-PSAC		RIYADH	SAUDI ARABIA	DRAWING NUMBER	SHEET NO.																																																																																																																			
								CD-323016	SHT CONT.																																																																																																																			
									011 012																																																																																																																			
									01																																																																																																																			

	1	2	3	4	5	6	7	8	9	10
A										
B										
C										
D										
E										
F										

SYMBOL	DESCRIPTION	SYMBOL	DESCRIPTION	SYMBOL	DESCRIPTION
	FUSE / LINK		WATTMETER		ELEMENT WITH NEGATED INHIBITING INPUT
	FUSE WITH THE SUPPLY SIDE INDICATED		VARMETER		ELEMENT WITH INPUT WHICH DOES NOT CARRY ANY LOGIC INFORMATION
	SINGLE-PHASE TRANSFORMER WITH TWO SEPARATE WINDINGS (TWO ALTERNATIVE FORMS)		POWER FACTOR METER		ELEMENT WITH POSTPONED OUTPUT
			POSITION INDICATOR		AND-ELEMENT WITH TWO INPUTS
	SINGLE-PHASE TRANSFORMER WITH FERRO MAGNETIC CORE		SYNCHROSCOPE		OR-ELEMENT WITH TWO INPUTS
	SINGLE-PHASE VOLTAGE TRANSFORMER (MULTI-LINE AND SINGLE-LINE REPRESENTATION)		RECORDING VOLTMETER		LOGIC THRESHOLD ELEMENT WITH FOUR INPUTS AND THRESHOLD VALUE 2
			RECORDING WATTMETER		ELEMENT WITH THREE INPUTS FOR "2 AND ONLY 2"
	CURRENT TRANSFORMER (MULTI-LINE AND SINGLE-LINE REPRESENTATION)		HOUR METER		EXCLUSIVE OR-ELEMENT WITH THREE INPUTS
			WATT-HOUR METER		LOGIC IDENTITY ELEMENT WITH THREE INPUTS
	CURRENT TRANSFORMER WITH TWO CORES (MULTI-LINE AND SINGLE-LINE REPRESENTATION)		WATT-HOUR METER FOR ENERGY FROM A BUSBAR SYSTEM		MAJORITY ELEMENT WITH THREE INPUTS
			ELEMENT WITH STATIC INPUT		NEGATOR
	CURRENT TRANSFORMER WITH TWO SECONDARY WINDINGS ON ONE CORE (MULTI-LINE AND SINGLE-LINE REPRESENTATION)		ELEMENT WITH STATIC NEGATED INPUT		NAND ELEMENT WITH TWO INPUTS
			ELEMENT WITH STATIC NEGATED OUTPUT		NOR ELEMENT WITH TWO INPUTS
	FILTER		ELEMENT WITH DYNAMIC INPUT		BISTABLE ELEMENT
	HIGH-PASS FILTER		ELEMENT WITH DYNAMIC NEGATED INPUT		
	BAND-PASS FILTER		ELEMENT WITH INHIBITING INPUT		
	VOLTMETER				
	AMMETER				

G

AS-BUILT BY _____		DATE _____	CONTRACT NO. 11131113/00	JOB ORDER NO. S-13656	GRAPHICAL SYMBOLS FOR DIAGRAMS		<div>نقل الكهرباء</div> <div>الشركة الوطنية لنقل الكهرباء</div> <div>National Grid SA</div>					
01	13 49	FACTORY ASBUILT		DRAWN BY RIZ CHECKED BY KVR		132KV BUSBAR PROTN.MAIN-2 BU PANEL +BBP2-6		INDEX	PLANT NO.	DRAWING NUMBER	SHEET NO.	REV. NO.
00	13 14	FOR APPROVAL		DATE STARTED 1.04.2013 DATE COMPLETED _____		S/S 8709 S-13656		-	C421	CD-323016	012/013	01
REV. NO.	DATE	DESCRIPTION		OPRG. DEPT. CTPD ENG. DEPT. AUT-PSAC		RIYADH SAUDI ARABIA						

	1	2	3	4	5	6	7	8	9	10
A										
B										
C										
D										
E										
F										

LEGENDS

±R1	DC SUPPLY – MAIN PROTECTION
±R2	DC SUPPLY – SECONDARY PROTECTION
±R3	DC SUPPLY – BACK UP PROTECTION
±IT	DC SUPPLY – INTER TRIP
FL	DC SUPPLY – FLASHING CIRCUIT
BB RS±	DC SUPPLY – BUS BAR – PROTECTION RESET
BB CBF±/CBF±	DC SUPPLY – CBF PROTECTION
R	RESET BUS – ALARM SYSTEM
CR	CONTROL ROOM
ECC	ENERGY CONTROL CENTRE
LOCAL	THE LOCATION OF CONTROLLED DEVICE
REMOTE	ANY OTHER LOCATION NOT LOCAL
ON	CB NORMALLY OPEN AUXILIARY CONTACT
OFF	CB NORMALLY CLOSED AUXILIARY CONTACT
A	COMMON
T	TEST POSITION
S	SERVICE POSITION
CS	CLOSE IN SERVICE POSITION
CT	CLOSE IN TEST POSITION
LS	LOCAL SERVICE
LT	LOCAL TEST
LC	LOCAL CLOSE
LO	LOCAL OPEN
RO	REMOTE OPEN
OP	OPERATE
RE	RESET

NOTES

LABELS

WHITE LABEL WITH BLACK LETTERING WILL BE PROVIDED FOR ALL MOUNTED APPARATUS EQUIPMENT IDENTIFICATION AND FUNCTION REFERENCE LABEL WILL BE PROVIDED FOR FRONT MOUNTED EQUIPMENTS OF THE PANEL AND EQUIPMENT IDENTIFICATION LABEL WILL BE PROVIDED FOR INTERNALLY MOUNTED EQUIPMENTS

WIRING

PVC INSULATED 600V GRADE
 2.5 SQ.mm. YELLOW COLOURED FOR CT CIRCUITS
 2.5 SQ.mm. RE COLOURED FOR VT CIRCUITS
 1.5 SQ.mm. GREY COLOURED FOR DC SUPPLY, SCADA AND CONTROL CIRCUITS
 2.5 SQ.mm. BLACK COLOURED FOR AVC AND AC CIRCUITS
 2.5 SQ.mm. YELLOW/GREEN COLOURED FOR EARTHING CONNECTIONS
 FOLLOWING MARKERS SHALL BE PROVIDED ON FOLLOWING WIRES:
 + SIGN FOR DC + WIRE
 – SIGN FOR DC – WIRE

LUGS

A. CT CIRCUITS– RING TYPE
 B. OTHER CIRCUITS – SPADE TYPE

FERULLING

YELLOW TUBE 3.2 mm FOR 1.5SQ mm WIRES AND 4.2 FOR 2.5 SQ mm WIRES
 (AS PER 31 – TMSS–1, RE.0)


AS-BUILT BY _____ DATE _____			CONTRACT NO. 11131113/00		JOB ORDER NO. S-13656		COMMON LEGEND				الشركة الوطنية لنقل الكهرباء National Grid sa			
01	13 49	FACTORY ASBUILT FOR APPROVAL	DRAWN BY RIZ		CHECKED BY KVR		132KV BUSBAR PROTN.MAIN-2 BU PANEL +BBP2-6				INDEX	PLANT NO.	DRAWING NUMBER	SHEET NO.
00	13 14		DATE STARTED 11.04.2013		DATE COMPLETED		S/S 8709 S-13656				-	C421	CD-323016	SHT CONT.
REV. NO.	DATE	DESCRIPTION	OPRG. DEPT. CTPD		ENG. DEPT. AUT-PSAC		RIYADH SAUDI ARABIA							01

	1	2	3	4	5	6	7	8	9	10															
A	<div style="text-align: center;"> <p>FOR 132kV RELAY & CONTROL, PROTN. PANELS</p> <p>AS PER IEC-391 FIG 14a (W/O SUPPLEMENTARY/IDENTIFICATION MARK)</p> </div>																								
B																									
C																									
D																									
E	<p>FOR 132kV PANELS INTERPANEL WIRING</p> <p>AS PER IEC-391 FIG 14d (W/O SUPPLEMENTARY/IDENTIFICATION MARK)</p>					<p>WIRES – PVC insulated, stranded, coiled annealed copper conductor graded for 1000V</p> <p>a. CT Circuits – 2.5 Sqmm PVC Yellow colour</p> <p>b. VT Circuits – 1.5 Sqmm PVC Red colour</p> <p>c. DC, & CONTROL Circuits – 1.5 Sqmm PVC Grey colour</p> <p>d. Alarm Circuits – 1.0 Sqmm PVC Blue colour</p> <p>e. AVC & AC Circuits – 2.5 Sqmm PVC Black colour</p> <p>f. Earth Circuits – 2.5 Sqmm PVC Yellow/Green colour</p>																			
F	<p>LUGS – Pre-Insulated</p> <p>a(CT Circuits – Ring type</p> <p>b(Other Circuits – Spode type</p>																								
G	<p>AS-BUILT BY _____ DATE _____ CONTRACT NO. 11131113/00 JOB ORDER NO. S-13656</p> <p>01 13 49 FACTORY ASBUILT DRAWN BY RIZ CHECKED BY KVR</p> <p>00 13 14 FOR APPROVAL DATE STARTED 11.04.2013 DATE COMPLETED _____</p> <p>REV. NO. DATE DESCRIPTION OPRG. DEPT. CTPD ENG. DEPT. AUT-PSAC</p>					<p>FERRULE AND WIRING DETAILS</p> <p>132KV BUSBAR PROTN.MAIN-2 BU PANEL +BBP2-6</p> <p>S/S 8709 S-13656</p> <p>RIYADH SAUDI ARABIA</p>					<p>الشركة الوطنية لنقل الكهرباء National Grid sa</p> <table border="1"> <tr> <th>INDEX</th> <th>PLANT NO.</th> <th>DRAWING NUMBER</th> <th>SHEET NO.</th> <th>REV. NO.</th> </tr> <tr> <td>-</td> <td>C421</td> <td>CD-323016</td> <td>014</td> <td>015</td> </tr> </table>					INDEX	PLANT NO.	DRAWING NUMBER	SHEET NO.	REV. NO.	-	C421	CD-323016	014	015
INDEX	PLANT NO.	DRAWING NUMBER	SHEET NO.	REV. NO.																					
-	C421	CD-323016	014	015																					




THIS DRAWING AND THE INFORMATION CONTAINED HEREIN ARE THE SOLE PROPERTY OF National Grid SA NO REPRODUCTION IN FULL OR IN PART SHALL BE OBTAINED FROM THIS DOCUMENT WITHOUT THE WRITTEN CONSENT OF ITS OWNER.


	1	2	3	4	5	6	7	8	9	10
A										
B										
C										
D										
E										
F										
G										

AS-BUILT BY _____ DATE _____		CONTRACT NO. 11131113/00	JOB ORDER NO. S-13656	DRAWING REFERENCES		الشركة الوطنية لنقل الكهرباء National Grid sa				
01	13 49	FACTORY ASBUILT	DRAWN BY RIZ	CHECKED BY KVR	132KV BUSBAR PROTN.MAIN-2 BU PANEL +BBP2-6	INDEX	PLANT NO.	DRAWING NUMBER	SHEET NO.	REV. NO.
00	13 14	FOR APPROVAL	DATE STARTED 1.04.2013	DATE COMPLETED	S/S 8709 S-13656				SHT CONT.	
REV. NO.	DATE	DESCRIPTION	OPRG. DEPT. CTPD	ENG. DEPT. AUT-PSAC	RIYADH SAUDI ARABIA	-	C421	CD-323016	015 016	01

MANUFACTURER		SCHEMATICS DWG.NO	PANEL DESCRIPTION	PANEL REFERENCE
 PROTECTION & SUBSTATION AUTOMATION			SS 8709 132kv RELAY PANELS	
		CD-322928	132/13.8kv GT-1 RELAY PANEL -1	+R05.1
			132/13.8kv GT-1 RELAY PANEL -2	+R05.2
		CD-322931	132/13.8kv GT-2 RELAY PANEL -1	+R01.1
			132/13.8kv GT-2 RELAY PANEL -2	+R01.2
		CD-322934	132/13.8kv GT-3 RELAY PANEL -1	+R04.1
			132/13.8kv GT-3 RELAY PANEL -2	+R04.2
		CD-322936	132/13.8kv TRANSFORMER-1,2& 3 AVC PANEL	+AVC
		CD-322922	132KV SPARE-1 UGF RELAY PANEL -1	+R07.1
			132KV SPARE-1 UGF RELAY PANEL -2	+R07.2
		CD-322916	132KV 8020 UGF RELAY PANEL -1	+R02.1
			132KV 8020 UGF RELAY PANEL -2	+R02.2
		CD-322919	132KV 8710 UGF RELAY PANEL -1	+R03.1
			132KV 8710 UGF RELAY PANEL -2	+R03.2
		CD-322925	132KV SPARE-2 UGF RELAY PANEL -1	+R06.1
			132KV SPARE-2 UGF RELAY PANEL -2	+R06.2
		CD-323012	132KV FOIP PANEL	+FOIP
		CD-322946	132kv BUS COUPLER-A	+R130
		CD-322948	132kv BUS COUPLER-B	+R230
		CD-322950	132kv BUS SECTION	+R120
		CD-322991	132kv BUSBAR PROTECTION MAIN-1 CENTRAL UNIT PANEL	+BBP1-1
		CD-322993	132kv BUSBAR PROTECTION MAIN-1 BAY UNIT PANEL	+BBP1-2
		CD-322995	132kv BUSBAR PROTECTION MAIN-1 BAY UNIT PANEL	+BBP1-3
CD-322997	132kv BUSBAR PROTECTION MAIN-1 BAY UNIT PANEL	+BBP1-4		
CD-322999	132kv BUSBAR PROTECTION MAIN-1 BAY UNIT PANEL	+BBP1-5		
CD-323001	132kv BUSBAR PROTECTION MAIN-2 CENTRAL UNIT PANEL	+BBP2-1		
CD-323003	132kv BUSBAR PROTECTION MAIN-2 BAY UNIT PANEL	+BBP2-5		
CD-323005	132kv BUSBAR PROTECTION MAIN-2 BAY UNIT PANEL	+BBP2-3		
CD-323007	132kv BUSBAR PROTECTION MAIN-2 BAY UNIT PANEL	+BBP2-4		
CD-323009	132kv BUSBAR PROTECTION MAIN-2 BAY UNIT PANEL	+BBP2-5		




NG/D2-D (2012/01)
DMS VECTOR NGD200

	1	2	3	4	5	6	7	8	9	10																																																	
A																																																											
B																																																											
C																																																											
D																																																											
E																																																											
F																																																											
G	<table><tr><td colspan="2">AS-BUILT BY _____ DATE _____</td><td>CONTRACT NO. 11131113/00</td><td>JOB ORDER NO. S-13656</td><td colspan="2">DRAWING REFERENCES</td><td colspan="4"><div>الشركة الوطنية لنقل الكهرباء</div><div> نقل الكهرباء National Grid sa</div></td></tr><tr><td>01</td><td>13 49</td><td colspan="2">FACTORY ASBUILT</td><td>DRAWN BY RIZ</td><td>CHECKED BY KVR</td><td colspan="2">132KV BUSBAR PROTN.MAIN-2 BU PANEL +BBP2-6</td><td>INDEX</td><td>PLANT NO.</td><td>DRAWING NUMBER</td><td>SHEET NO.</td><td>REV. NO.</td></tr><tr><td>00</td><td>13 14</td><td colspan="2">FOR APPROVAL</td><td colspan="2">DATE STARTED 11.04.2013 DATE COMPLETED _____</td><td colspan="2">S/S 8709 S-13656</td><td></td><td></td><td></td><td>SHT CONT.</td><td></td></tr><tr><td>REV. NO.</td><td>DATE</td><td colspan="2">DESCRIPTION</td><td colspan="2">OPRG. DEPT. CTPD ENG. DEPT. AUT-PSAC</td><td colspan="2">RIYADH SAUDI ARABIA</td><td>-</td><td>C421</td><td>CD-323016</td><td>016 051</td><td>01</td></tr></table>										AS-BUILT BY _____ DATE _____		CONTRACT NO. 11131113/00	JOB ORDER NO. S-13656	DRAWING REFERENCES		<div>الشركة الوطنية لنقل الكهرباء</div> <div> نقل الكهرباء National Grid sa</div>				01	13 49	FACTORY ASBUILT		DRAWN BY RIZ	CHECKED BY KVR	132KV BUSBAR PROTN.MAIN-2 BU PANEL +BBP2-6		INDEX	PLANT NO.	DRAWING NUMBER	SHEET NO.	REV. NO.	00	13 14	FOR APPROVAL		DATE STARTED 11.04.2013 DATE COMPLETED _____		S/S 8709 S-13656					SHT CONT.		REV. NO.	DATE	DESCRIPTION		OPRG. DEPT. CTPD ENG. DEPT. AUT-PSAC		RIYADH SAUDI ARABIA		-	C421	CD-323016	016 051	01
AS-BUILT BY _____ DATE _____		CONTRACT NO. 11131113/00	JOB ORDER NO. S-13656	DRAWING REFERENCES		<div>الشركة الوطنية لنقل الكهرباء</div> <div> نقل الكهرباء National Grid sa</div>																																																					
01	13 49	FACTORY ASBUILT		DRAWN BY RIZ	CHECKED BY KVR	132KV BUSBAR PROTN.MAIN-2 BU PANEL +BBP2-6		INDEX	PLANT NO.	DRAWING NUMBER	SHEET NO.	REV. NO.																																															
00	13 14	FOR APPROVAL		DATE STARTED 11.04.2013 DATE COMPLETED _____		S/S 8709 S-13656					SHT CONT.																																																
REV. NO.	DATE	DESCRIPTION		OPRG. DEPT. CTPD ENG. DEPT. AUT-PSAC		RIYADH SAUDI ARABIA		-	C421	CD-323016	016 051	01																																															

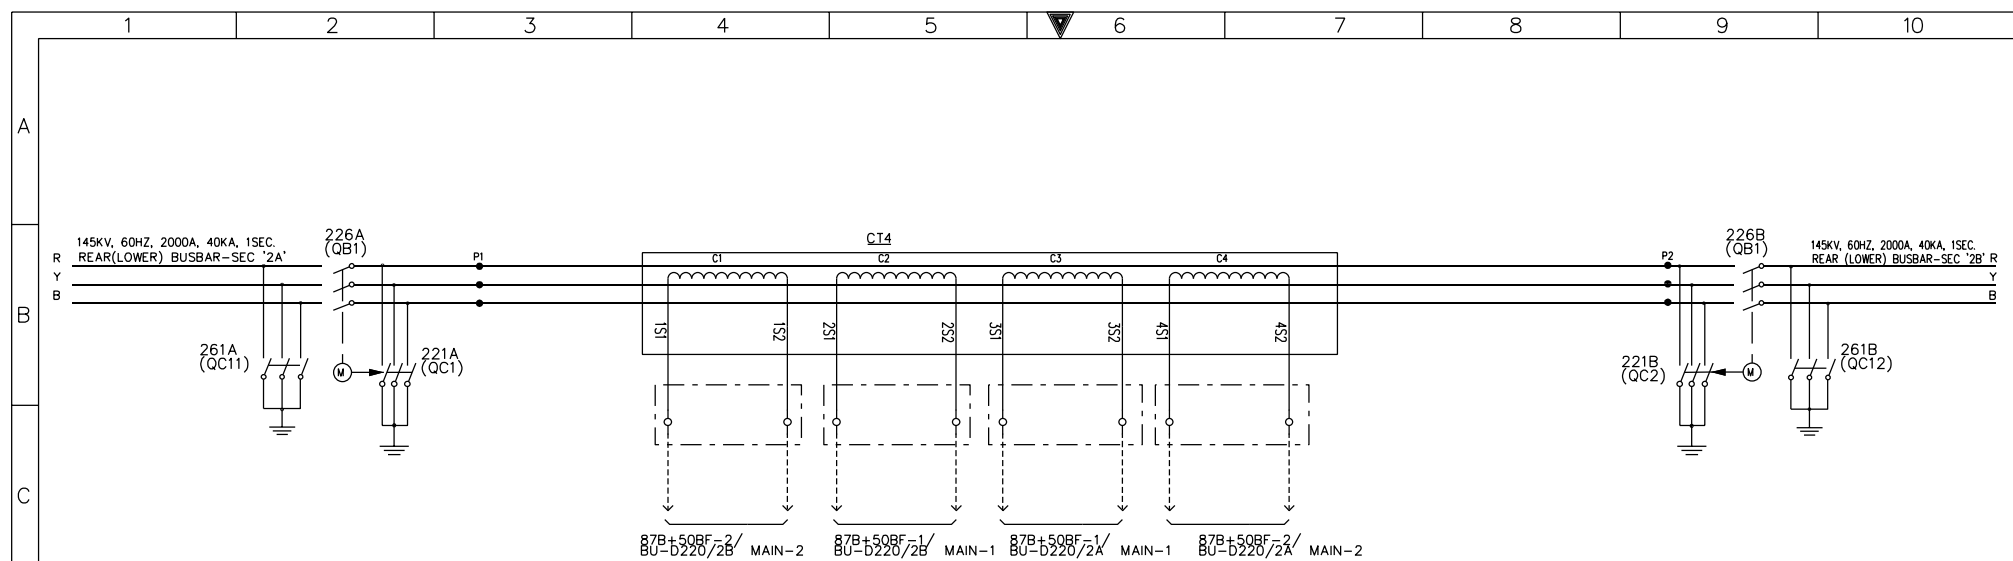

LOCATION OF GIS CT	CT	RATIO	CLASS	VK IN VOLT	Image IN mA @ VK	RCT IN OHMS	BURDEN IN VA	BURDEN IN VA
BUS 2A/2B	CT4 CORE-1	2000/1A	X	>600 at 2000/1A TAP	< = 25	<5	--	87B+50BF-2/BU-D220/2B MAIN-2
	CT4 CORE-2	2000/1A	X	>600 at 2000/1A TAP	< = 25	<5	--	87B+50BF-1/BU-D220/2B MAIN-1
	CT4 CORE-3	2000/1A	X	>600 at 2000/1A TAP	< = 25	<5	--	87B+50BF-1/BU-D220/2A MAIN-1
	CT4 CORE-4	2000/1A	X	>600 at 2000/1A TAP	< = 25	<5	--	87B+50BF-2/BU-D220/2A MAIN-2

AS-BUILT BY _____ DATE _____			CONTRACT NO. 1113113/00		JOB ORDER NO. S-13656		PRIMARY SYSTEM D220		الشركة الوطنية لنقل الكهرباء			
01 13 49			DRAWN BY RIZ		CHECKED BY KVR		32KV BUSBAR PROTN.MAIN-2 BU PANEL +BBP2-6		National Grid sa			
00 13 14			DATE STARTED 11.04.2013		DATE COMPLETED		S/S 8709 S-13656		INDEX PLANT NO. DRAWING NUMBER SHEET NO. CONT.			
REV. NO. DATE DESCRIPTION			OPRG. DEPT. CTPD		ENG. DEPT. AUT-PSAC		RIYADH SAUDI ARABIA		C421 CD-323016 051 211 01			

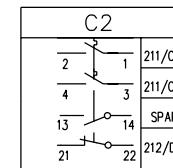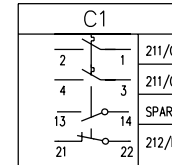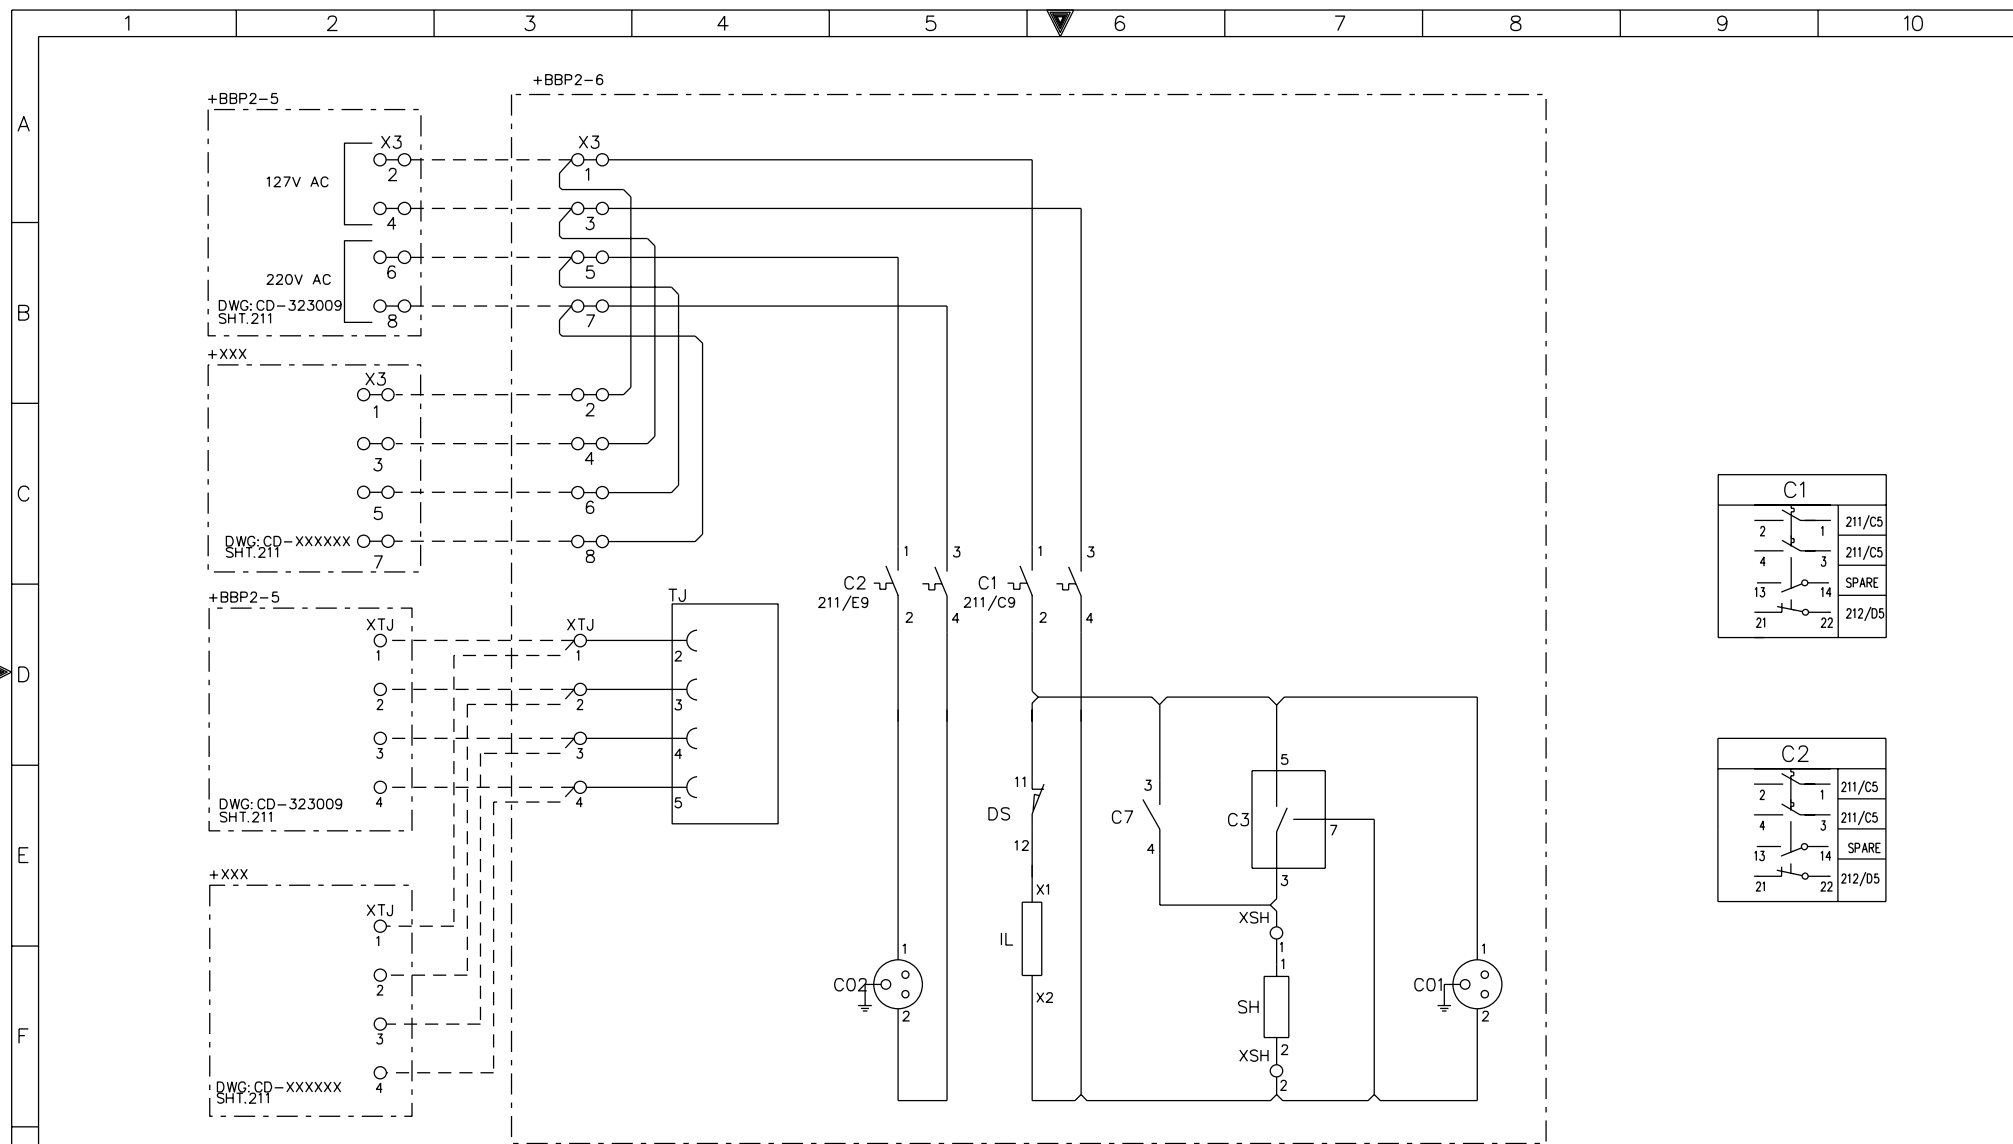

AS-BUILT BY _____ DATE _____

CONTRACT NO. 1113113/00

JOB ORDER NO. S-13656

01

13 49

FACTORY ASBUILT

00

13 14

FOR APPROVAL

REV. NO.

DATE

DESCRIPTION

DRAWN BY RIZ

CHECKED BY KVR

DATE STARTED 11.04.2013

DATE COMPLETED _____

OPRG. DEPT. CTPD

ENG. DEPT. AUT-PSAC

AC SUPPLY FOR ILLUMINATION &POWER SOCKET

132KV BUSBAR PROTN.MAIN-2 BU PANEL +BBP2-6

S/S 8709

S-13656

RIYADH

SAUDI ARABIA

الشركة الوطنية لنقل الكهرباء

National Grid SA

INDEX

PLANT NO.

DRAWING NUMBER

SHEET NO.

REV. NO.


-

C421


CD-323016

211 | 212

01

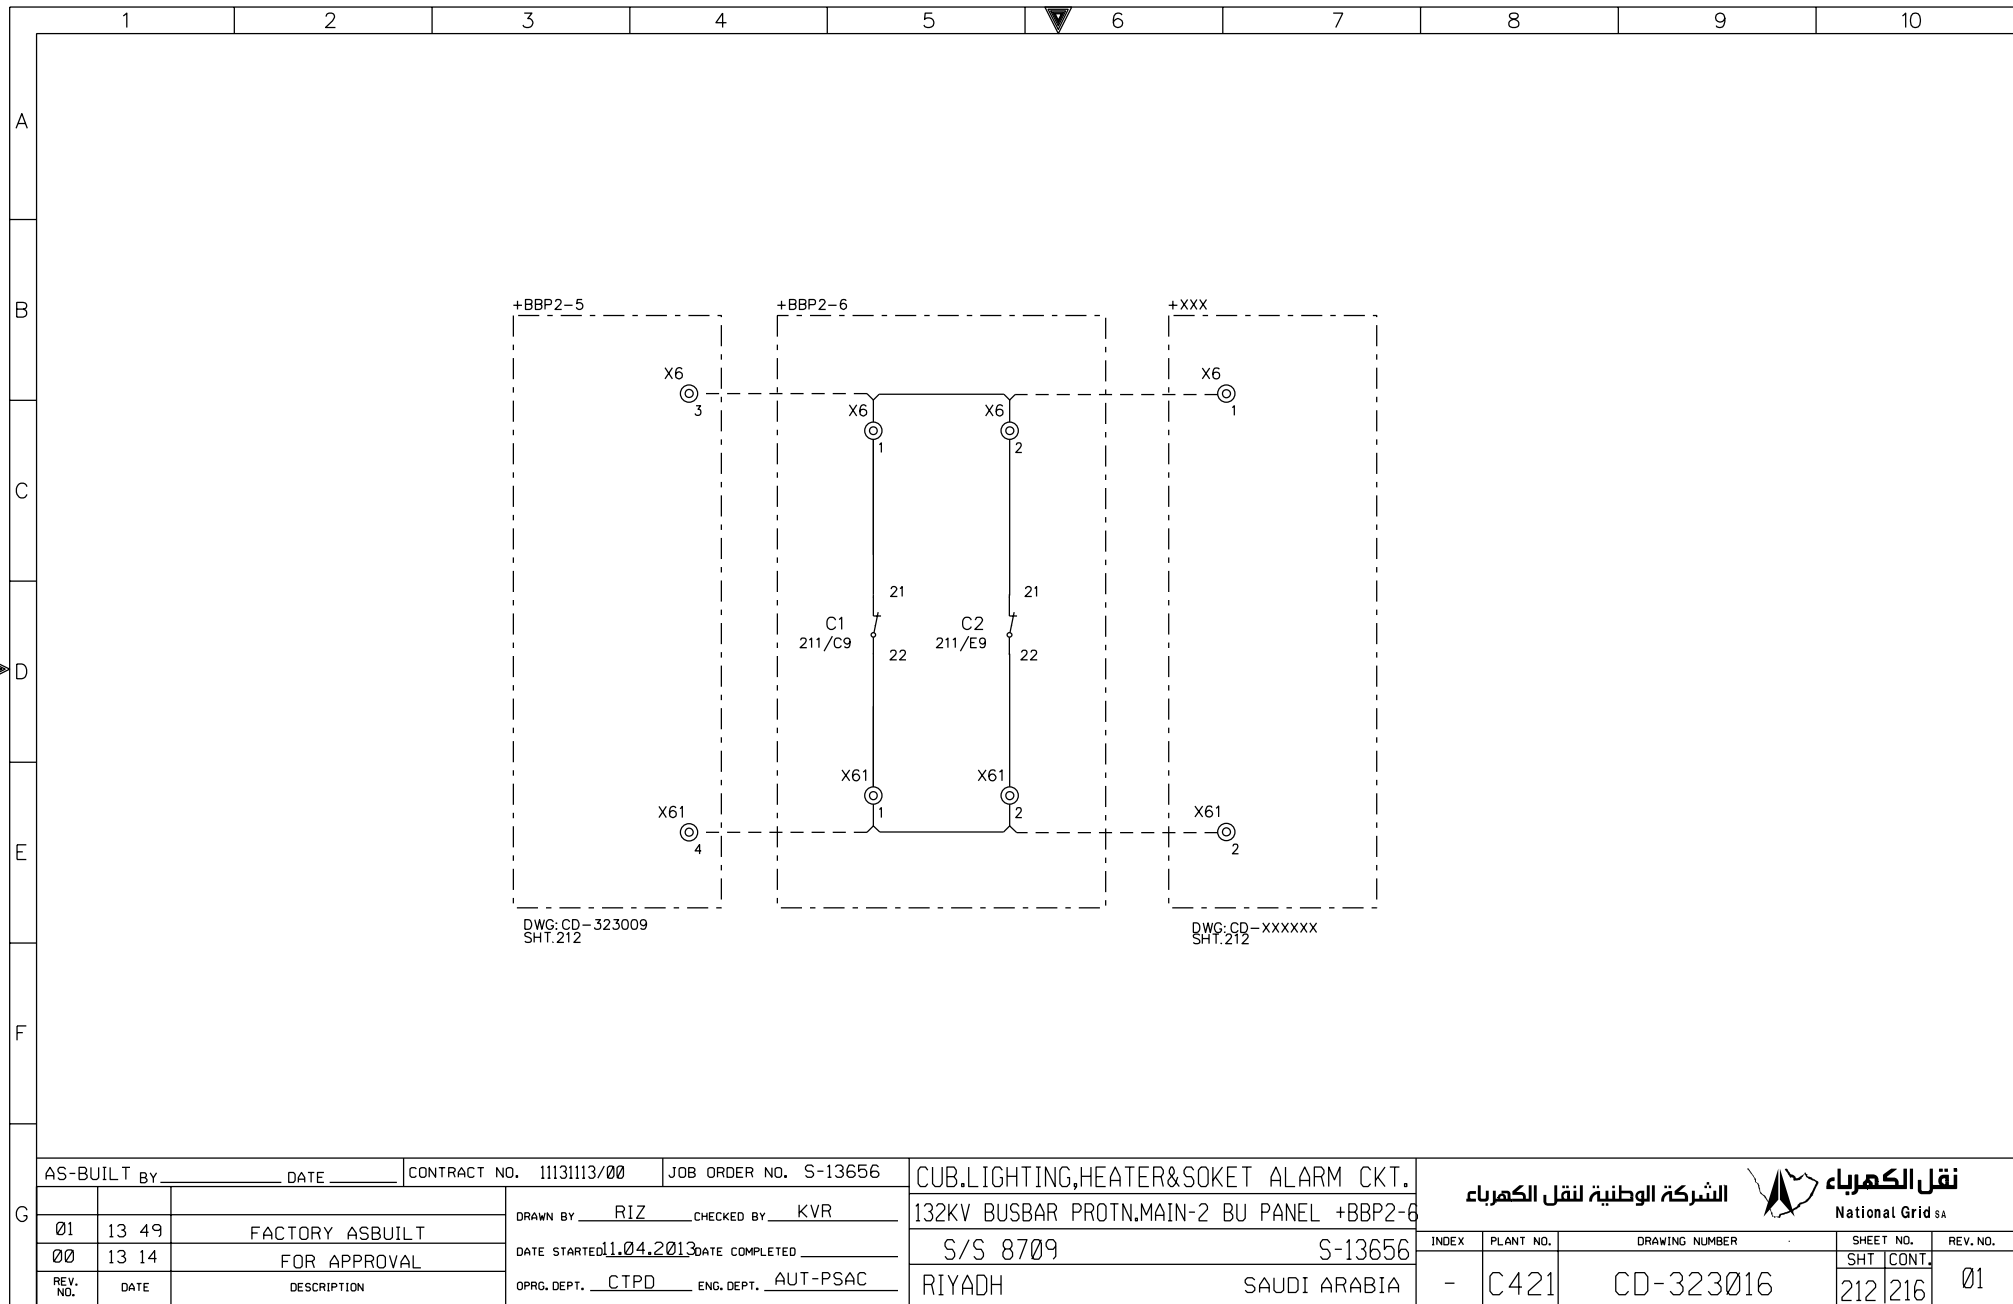


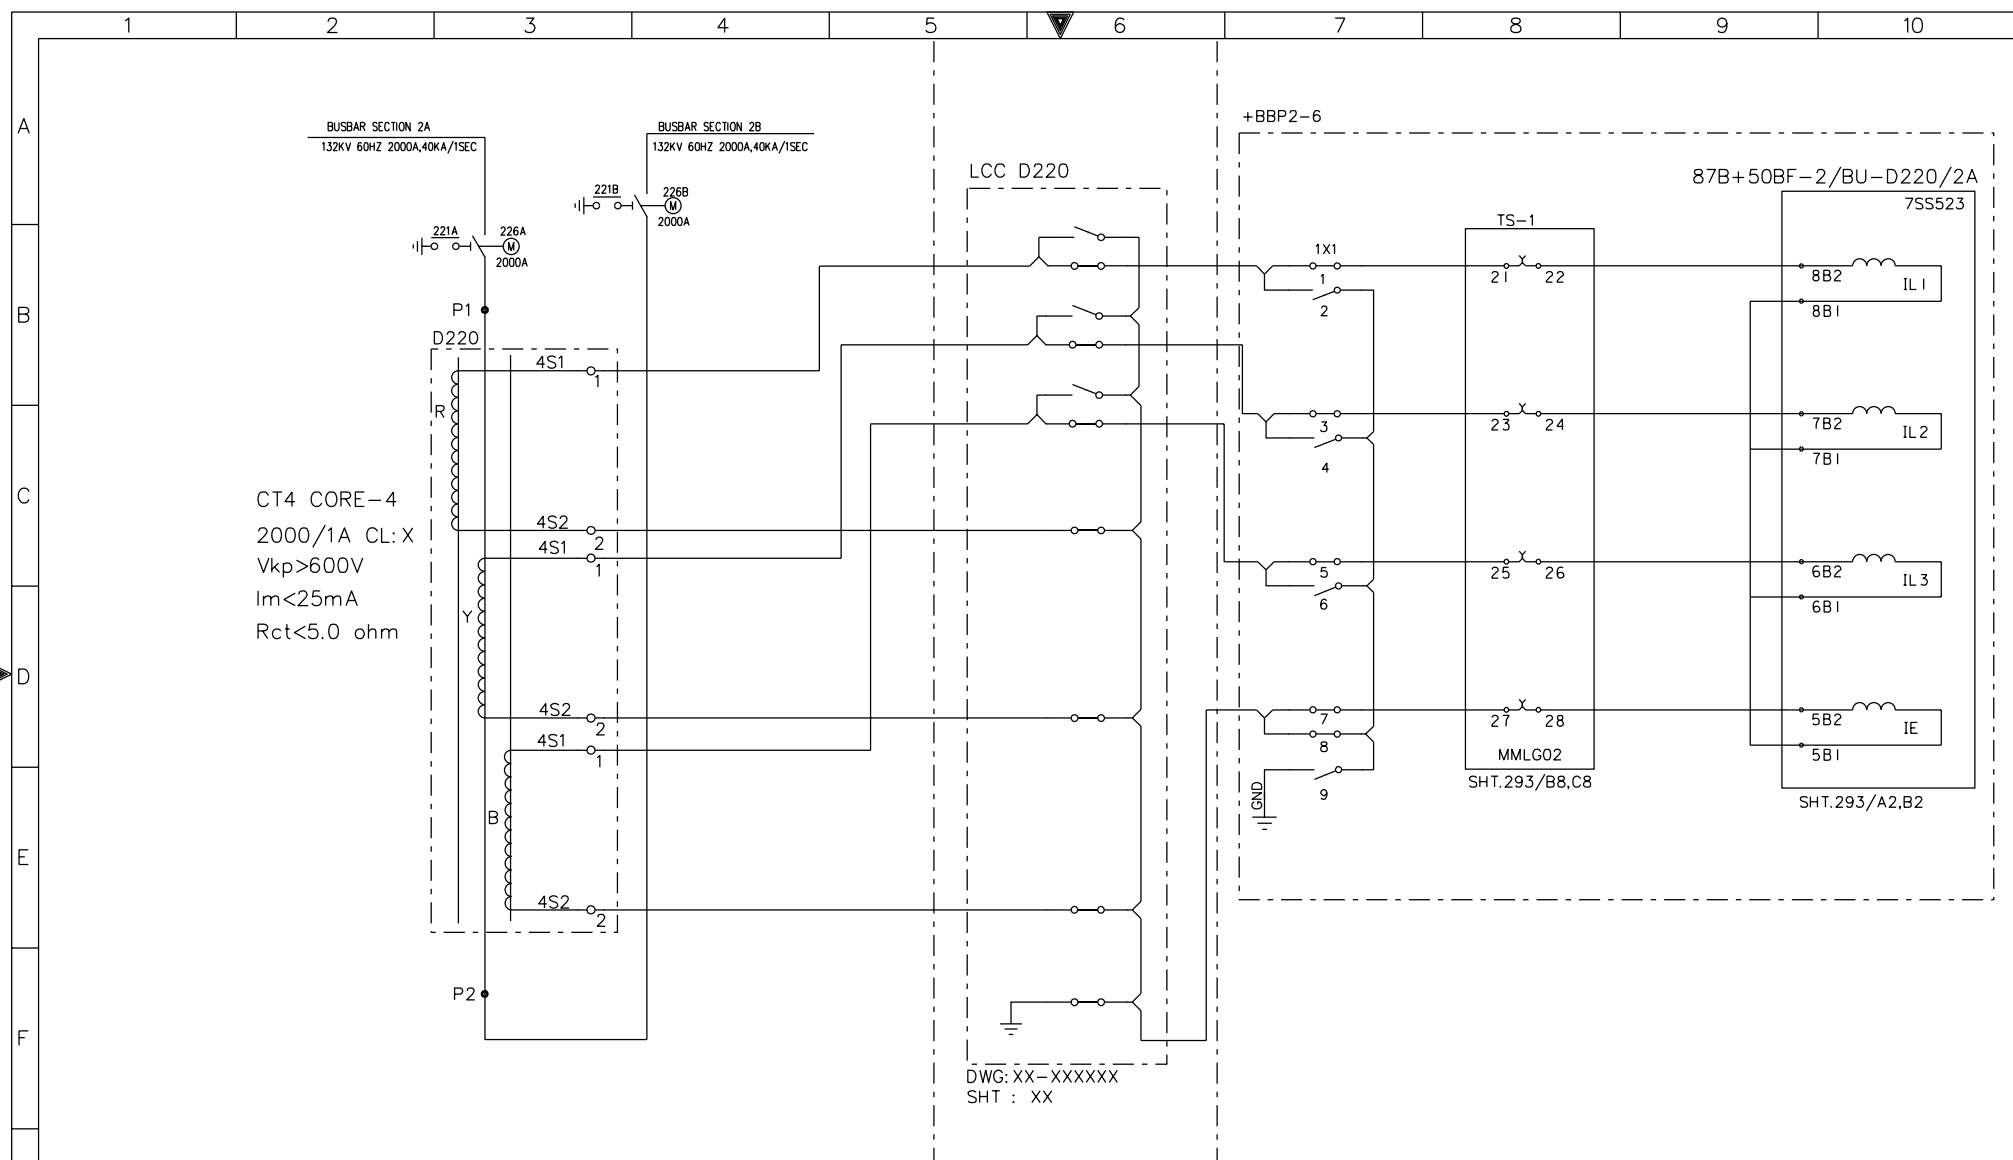
THIS DRAWING AND THE INFORMATION CONTAINED HEREIN ARE THE SOLE PROPERTY OF National Grid SA. NO REPRODUCTION IN FULL OR IN PART SHALL BE OBTAINED FROM THIS DOCUMENT WITHOUT THE WRITTEN CONSENT OF ITS OWNER.

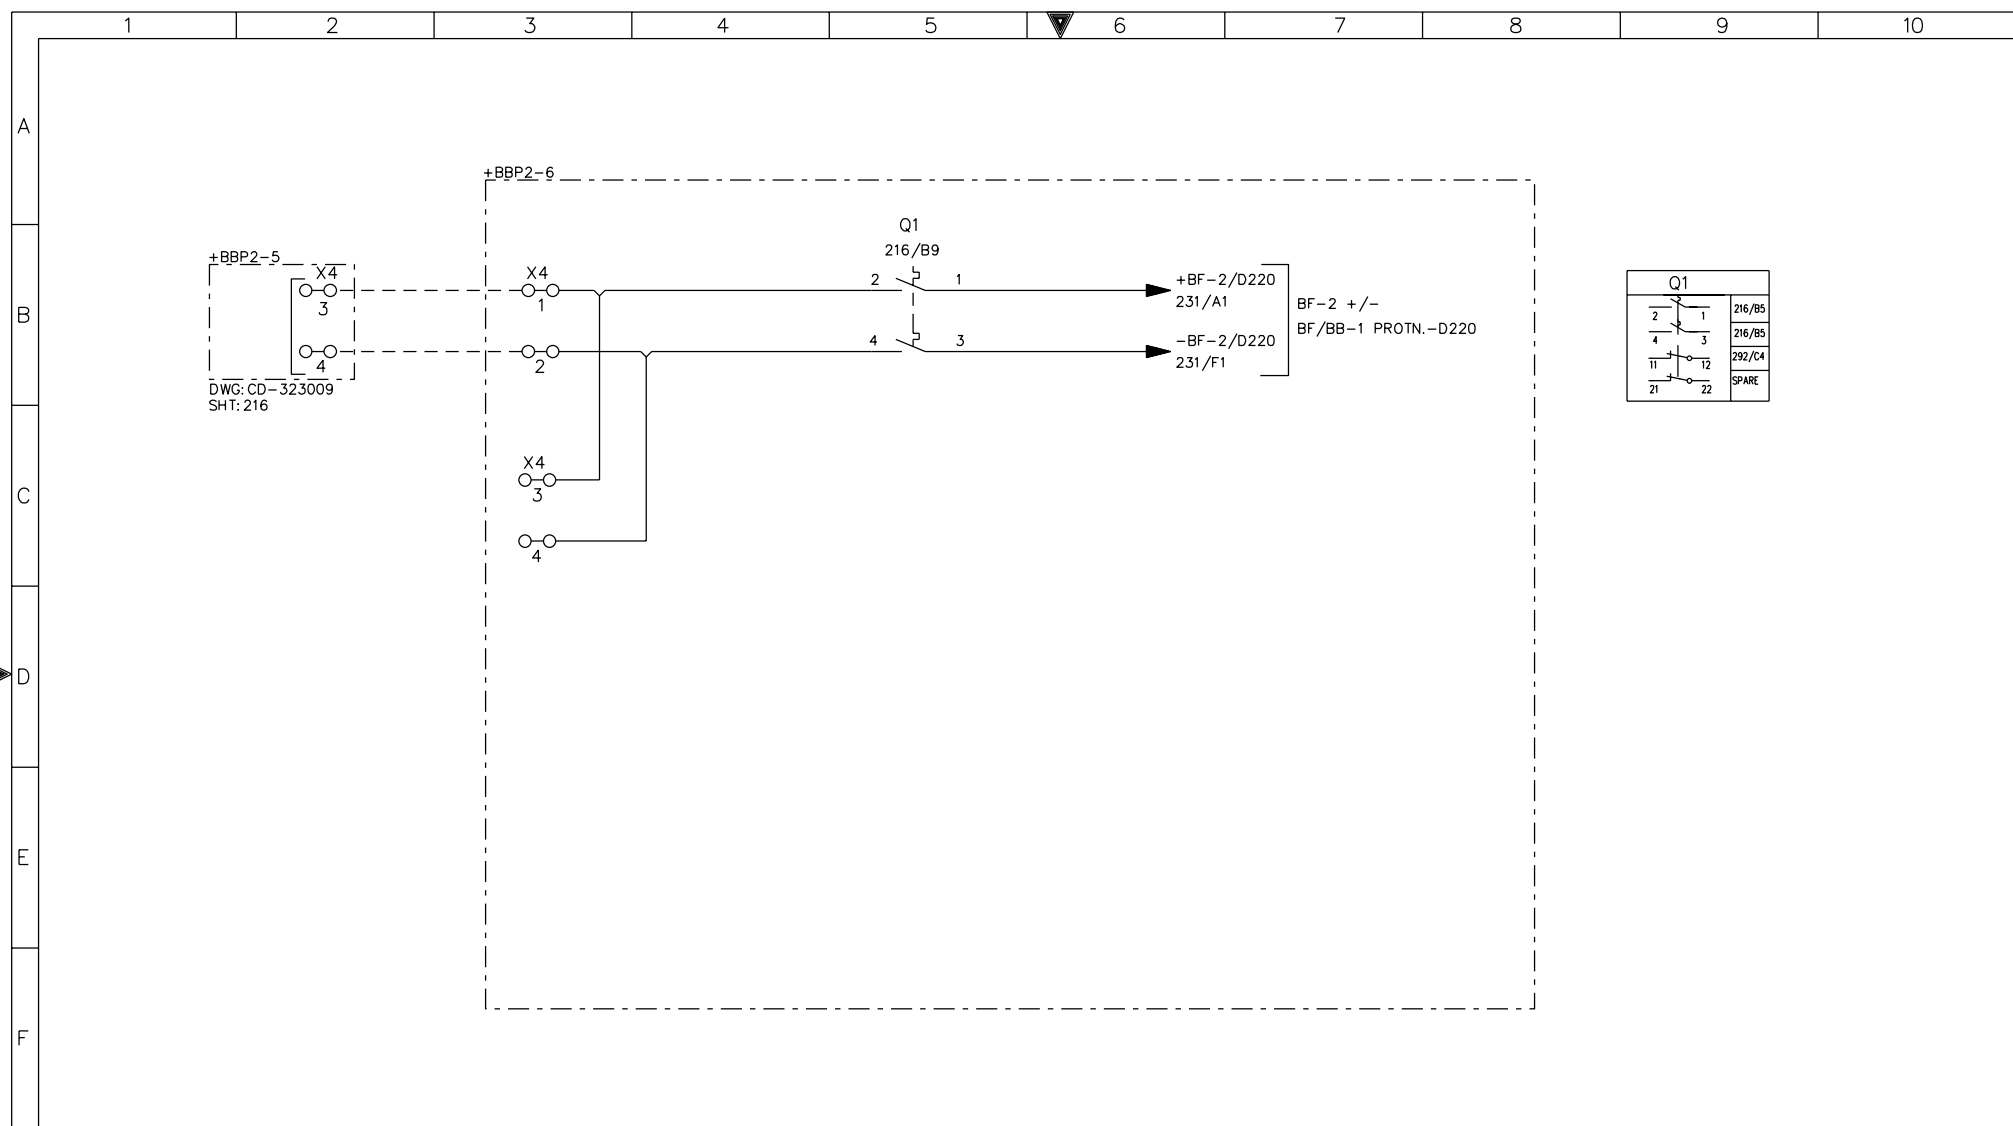

Q1			
2	1	216/B5	
4	3	216/B5	
11	12	292/C4	
21	22	SPARE	

G

AS-BUILT BY _____ DATE _____			CONTRACT NO. 11131113/00		JOB ORDER NO. S-13656		DC SUPPLY DISTRIBUTION		<div>نقل الكهرباء</div> <div>الشركة الوطنية لنقل الكهرباء</div> <div>National Grid SA</div>					
01	13	49	FACTORY ASBUILT		DRAWN BY RIZ CHECKED BY KVR		132KV BUSBAR PROTN.MAIN-2 BU PANEL +BBP2-6		INDEX	PLANT NO.	DRAWING NUMBER		SHEET NO.	REV. NO.
00	13	14	FOR APPROVAL		DATE STARTED 11.04.2013 DATE COMPLETED _____		S/S 8709 S-13656		-	C421	CD-323016		SHT CONT.	01
REV. NO.	DATE	DESCRIPTION		OPRG. DEPT. CTPD ENG. DEPT. AUT-PSAC		RIYADH SAUDI ARABIA								



AS-BUILT BY _____ DATE _____

CONTRACT NO. 11131113/00

JOB ORDER NO. S-13656

0113 49FACTORY ASBUILT

0013 14FOR APPROVAL

REV. NO. DATE DESCRIPTION

DRAWN BY RIZ CHECKED BY KVR

DATE STARTED11.04.2013DATE COMPLETED

OPRG. DEPT. CTPD ENG. DEPT. AUT-PSAC


CURRENT TRANSFORMER INPUTS -87B+50BF-2/BU-D220/2A

132KV BUSBAR PROTN.MAIN-2 BU PANEL +BBP2-6

S/S 8709S-13656

RIYADHSAUDI ARABIA


الشركة الوطنية لنقل الكهرباء



National Grid SA


INDEX	PLANT NO.	DRAWING NUMBER	SHEET NO.	REV. NO.
-	C421	CD-323016	SHT CONT. 221222	01

THIS DRAWING AND THE INFORMATION CONTAINED HEREIN ARE THE SOLE PROPERTY OF NATIONAL GRID SA. NO REPRODUCTION IN FULL OR IN PART SHALL BE OBTAINED FROM THIS DOCUMENT WITHOUT THE WRITTEN CONSENT OF ITS OWNER.

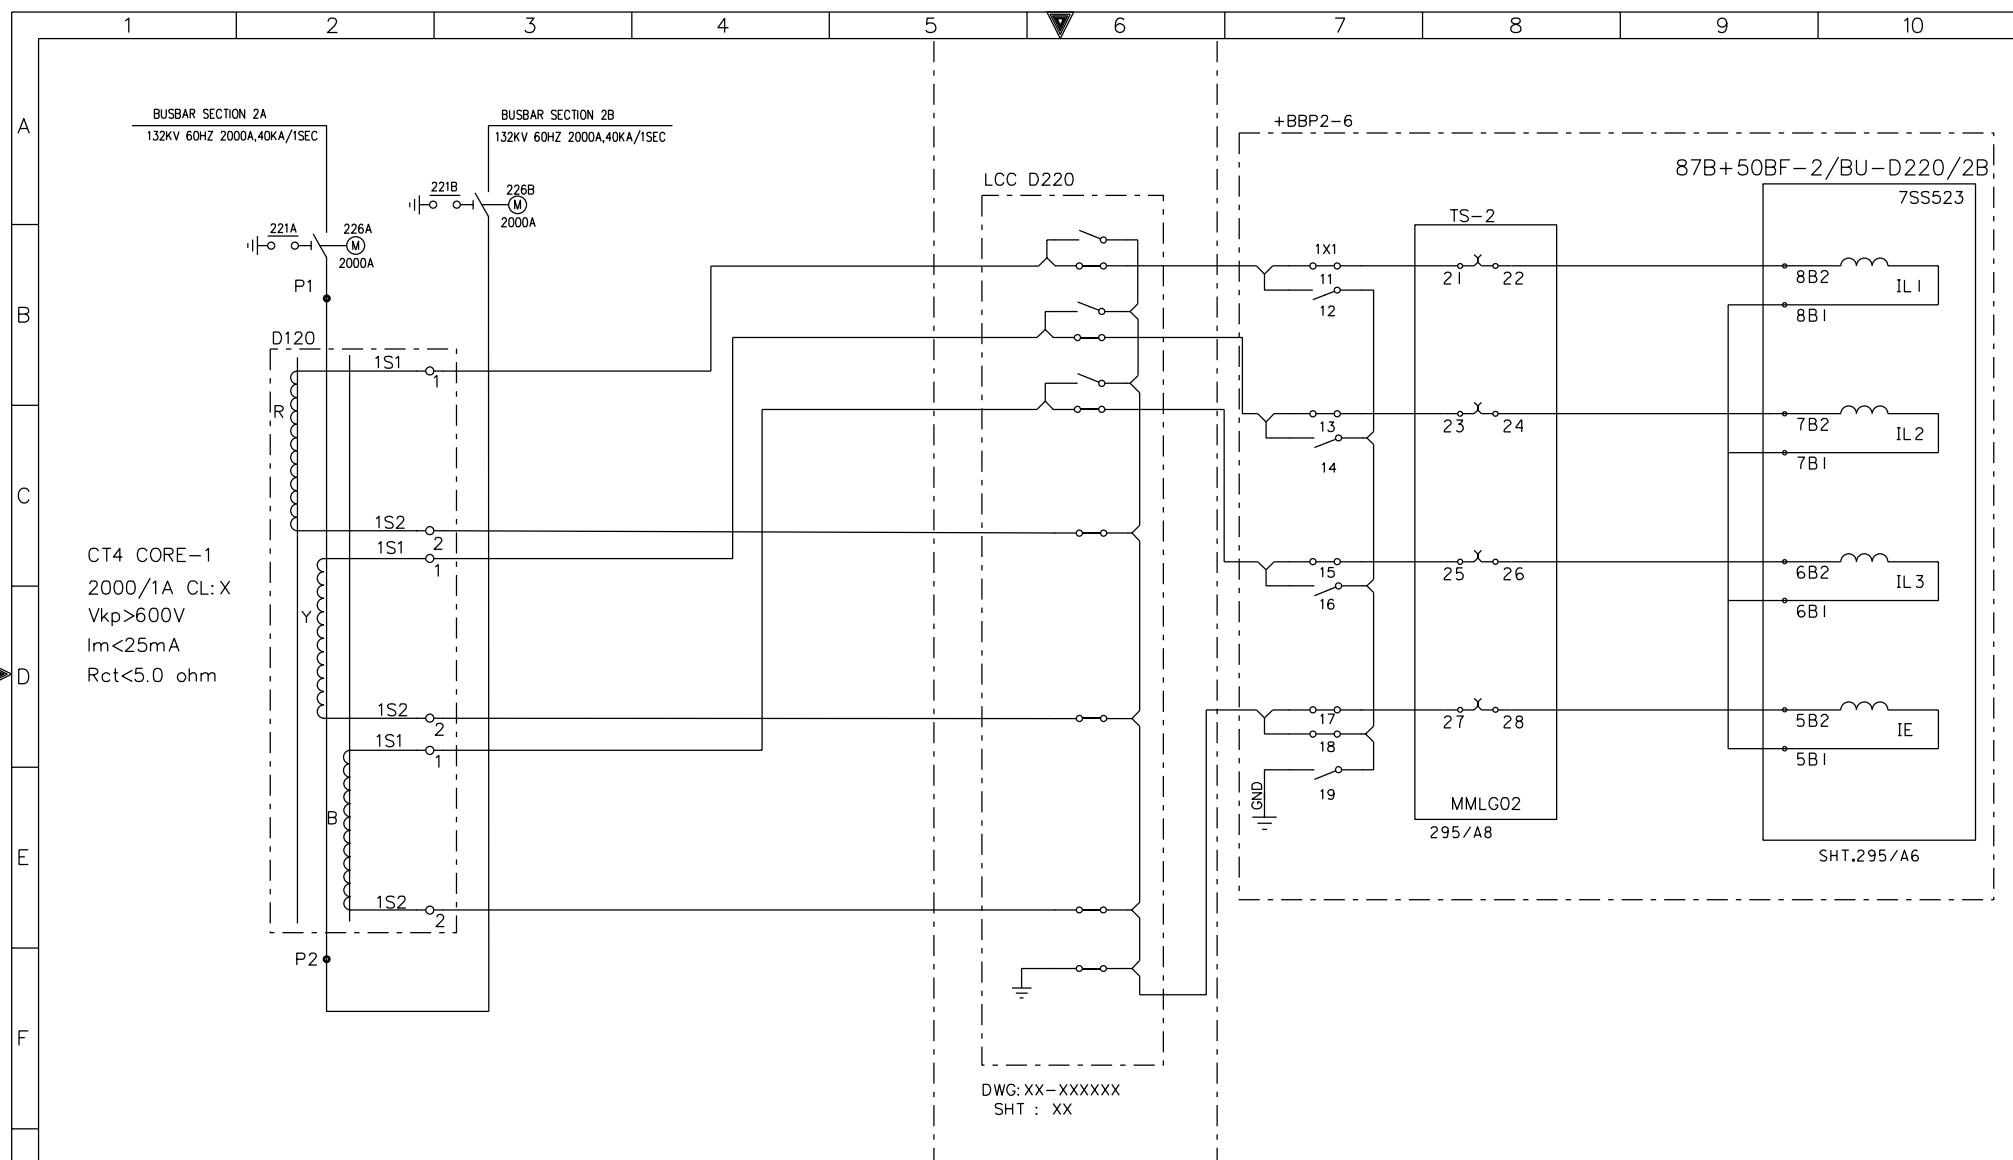

AS-BUILT BY _____ DATE _____		CONTRACT NO. 11131113/00		JOB ORDER NO. S-13656		CURRENT TRANSFORMER INPUTS -87B+50BF-2/BU-D220/2B	
01	13 49	FACTORY ASBUILT		DRAWN BY RIZ CHECKED BY KVR		132KV BUSBAR PROTN,MAIN-2 BU PANEL +BBP2-6	
00	13 14	FOR APPROVAL		DATE STARTED 11.04.2013 DATE COMPLETED _____		S/S 8709 S-13656	
REV. NO.	DATE	DESCRIPTION		OPRG. DEPT. CTPD ENG. DEPT. AUT-PSAC		RIYADH SAUDI ARABIA	

INDEX	PLANT NO.	DRAWING NUMBER	SHEET NO.	REV. NO.
-	C421	CD-323016	222/231	01

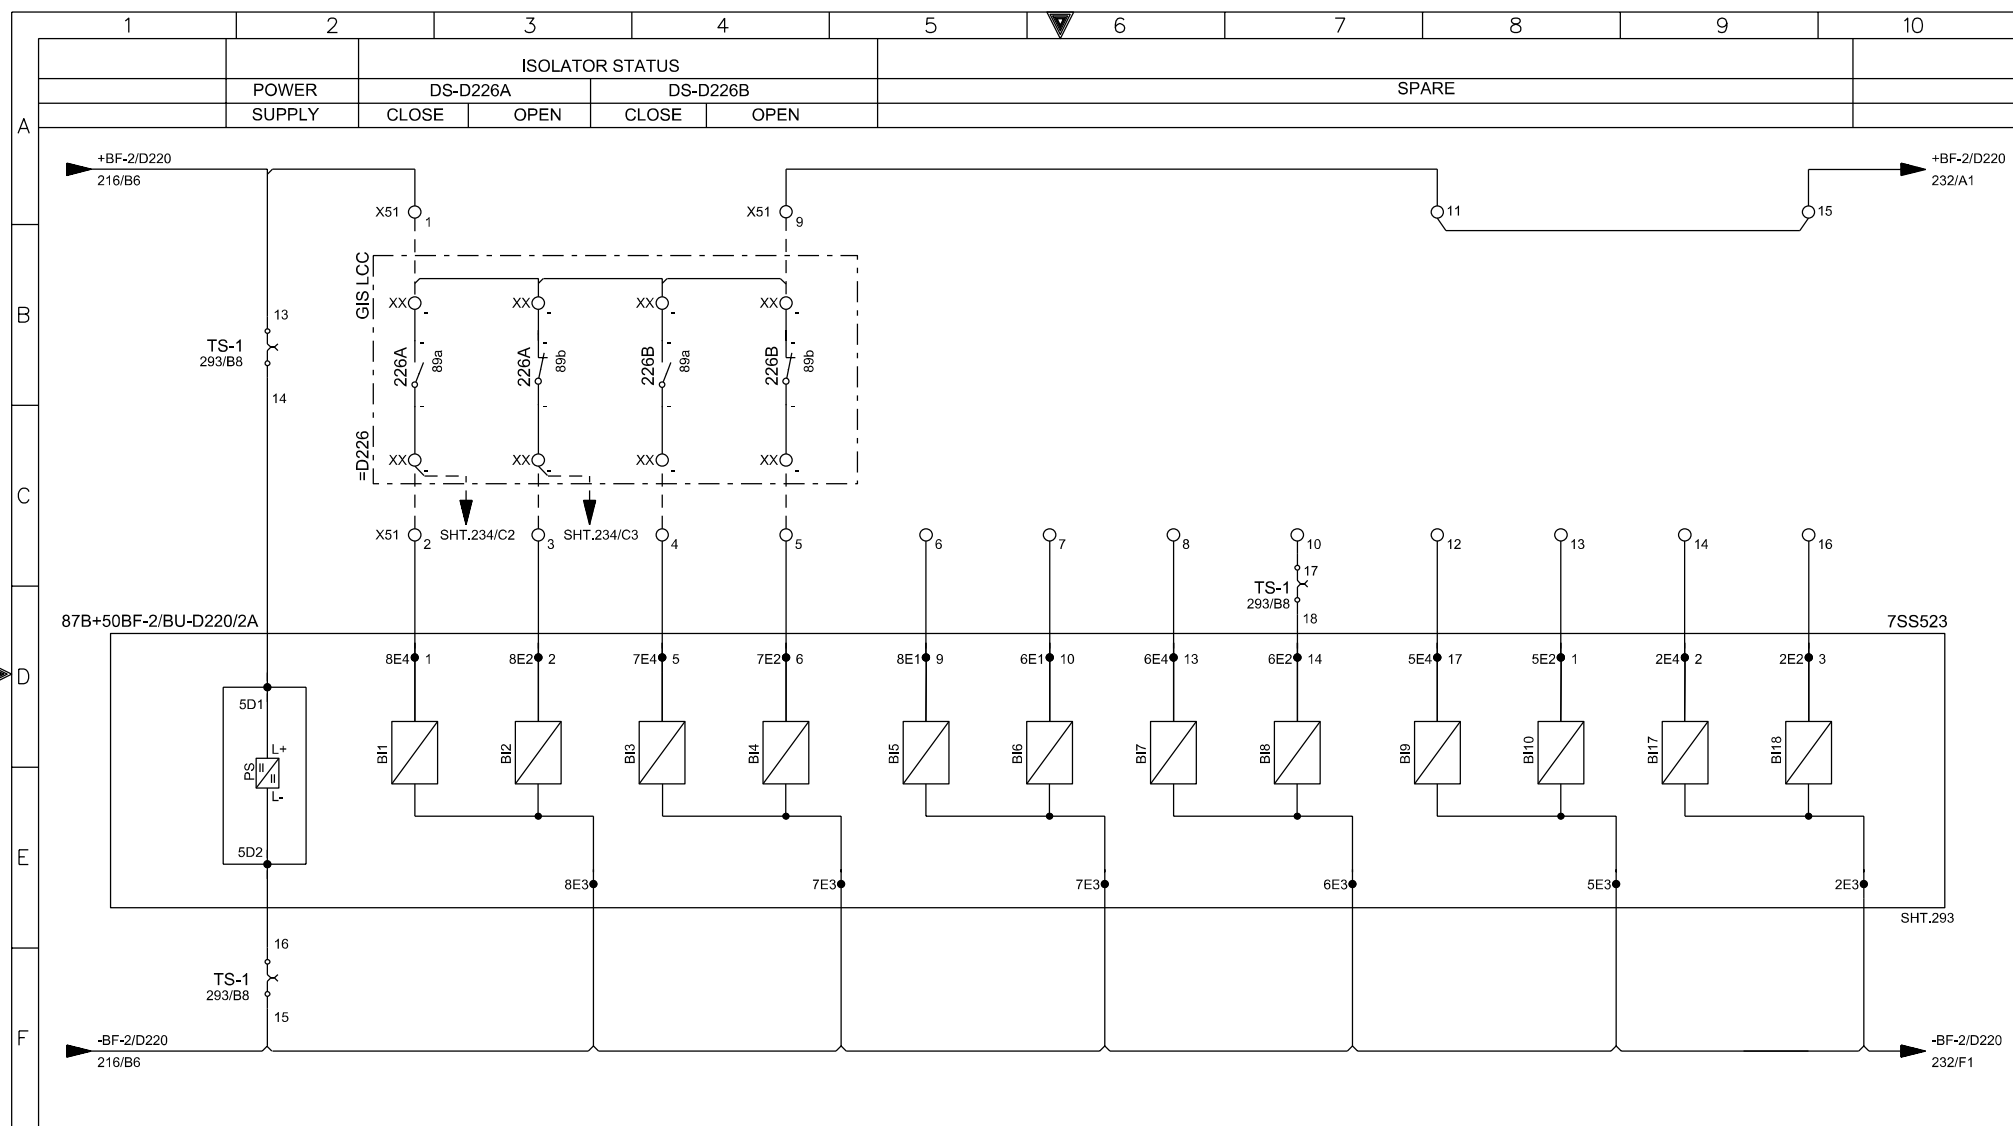

AS-BUILT BY

DATE

CONTRACT NO. 11131113/00

JOB ORDER NO. S-13656

87B+50BF-2/BU-D220/2A PROTN.RELAY - BINARY INPUTS

132KV BUSBAR PROTN.MAIN-2 BU PANEL +BBP2-6

S/S 8709

S-13656

RIYADH

SAUDI ARABIA

01

13 49

FACTORY ASBUILT

00

13 14

FOR APPROVAL

REV. NO.

DATE

DESCRIPTION

DRAWN BY RIZ

CHECKED BY KVR

DATE STARTED 11.04.2013

DATE COMPLETED

OPRG. DEPT. CTPD

ENG. DEPT. AUT-PSAC

الشركة الوطنية لنقل الكهرباء

نقل الكهرباء

National Grid sa

INDEX

PLANT NO.

DRAWING NUMBER

SHEET NO.

REV. NO.


-

C421

CD-323016

231 | 232

01

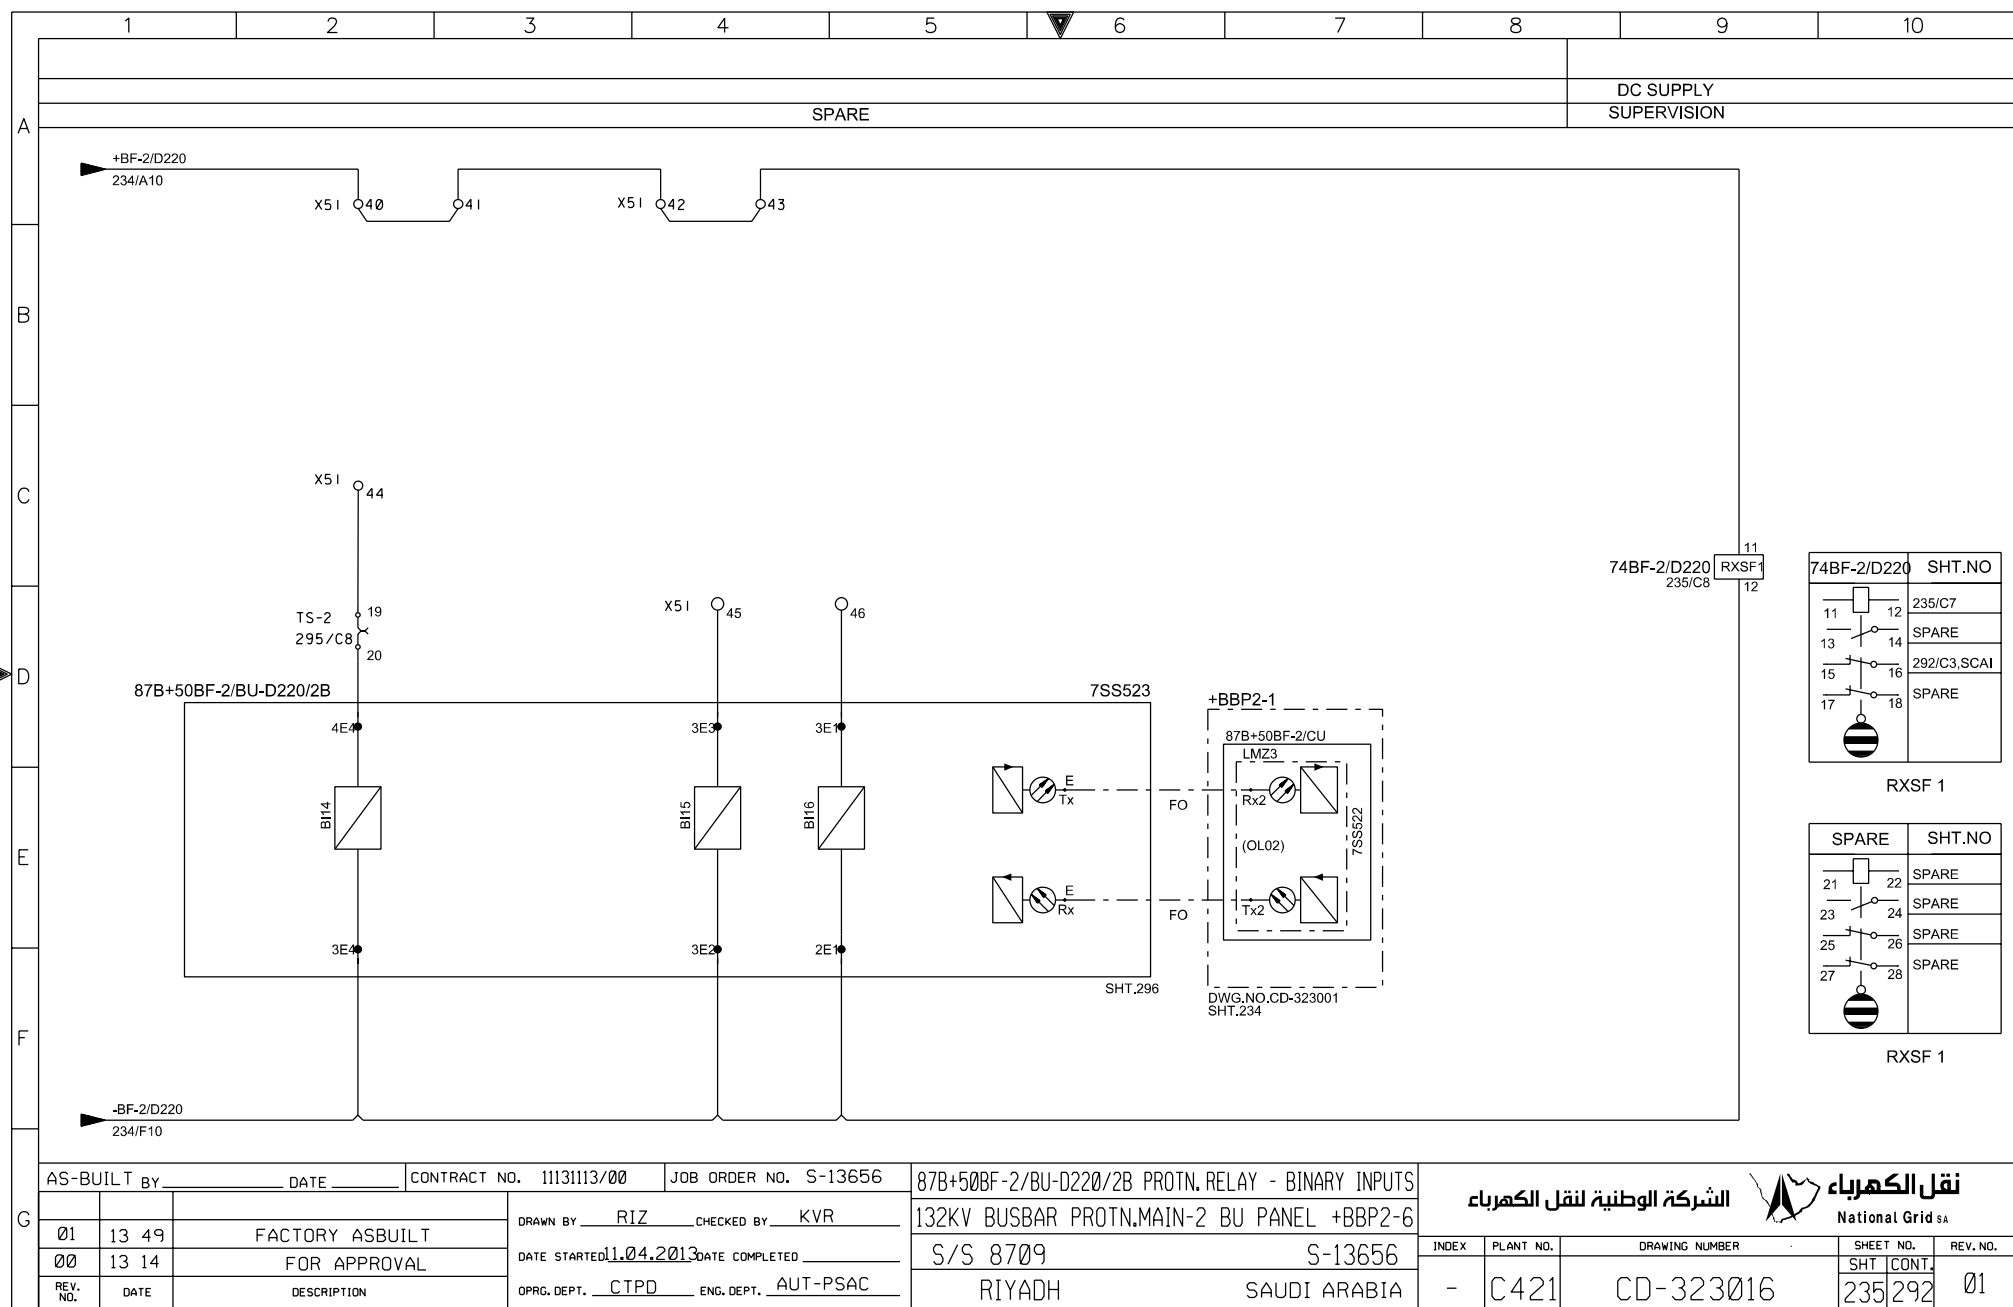




الشركة الوطنية لنقل الكهرباء
National Grid sa




نقل الكهرباء
National Grid sa

INDEX	PLANT NO.	DRAWING NUMBER	SHEET NO.	REV. NO.
-	C421	CD-323016	235/292	01

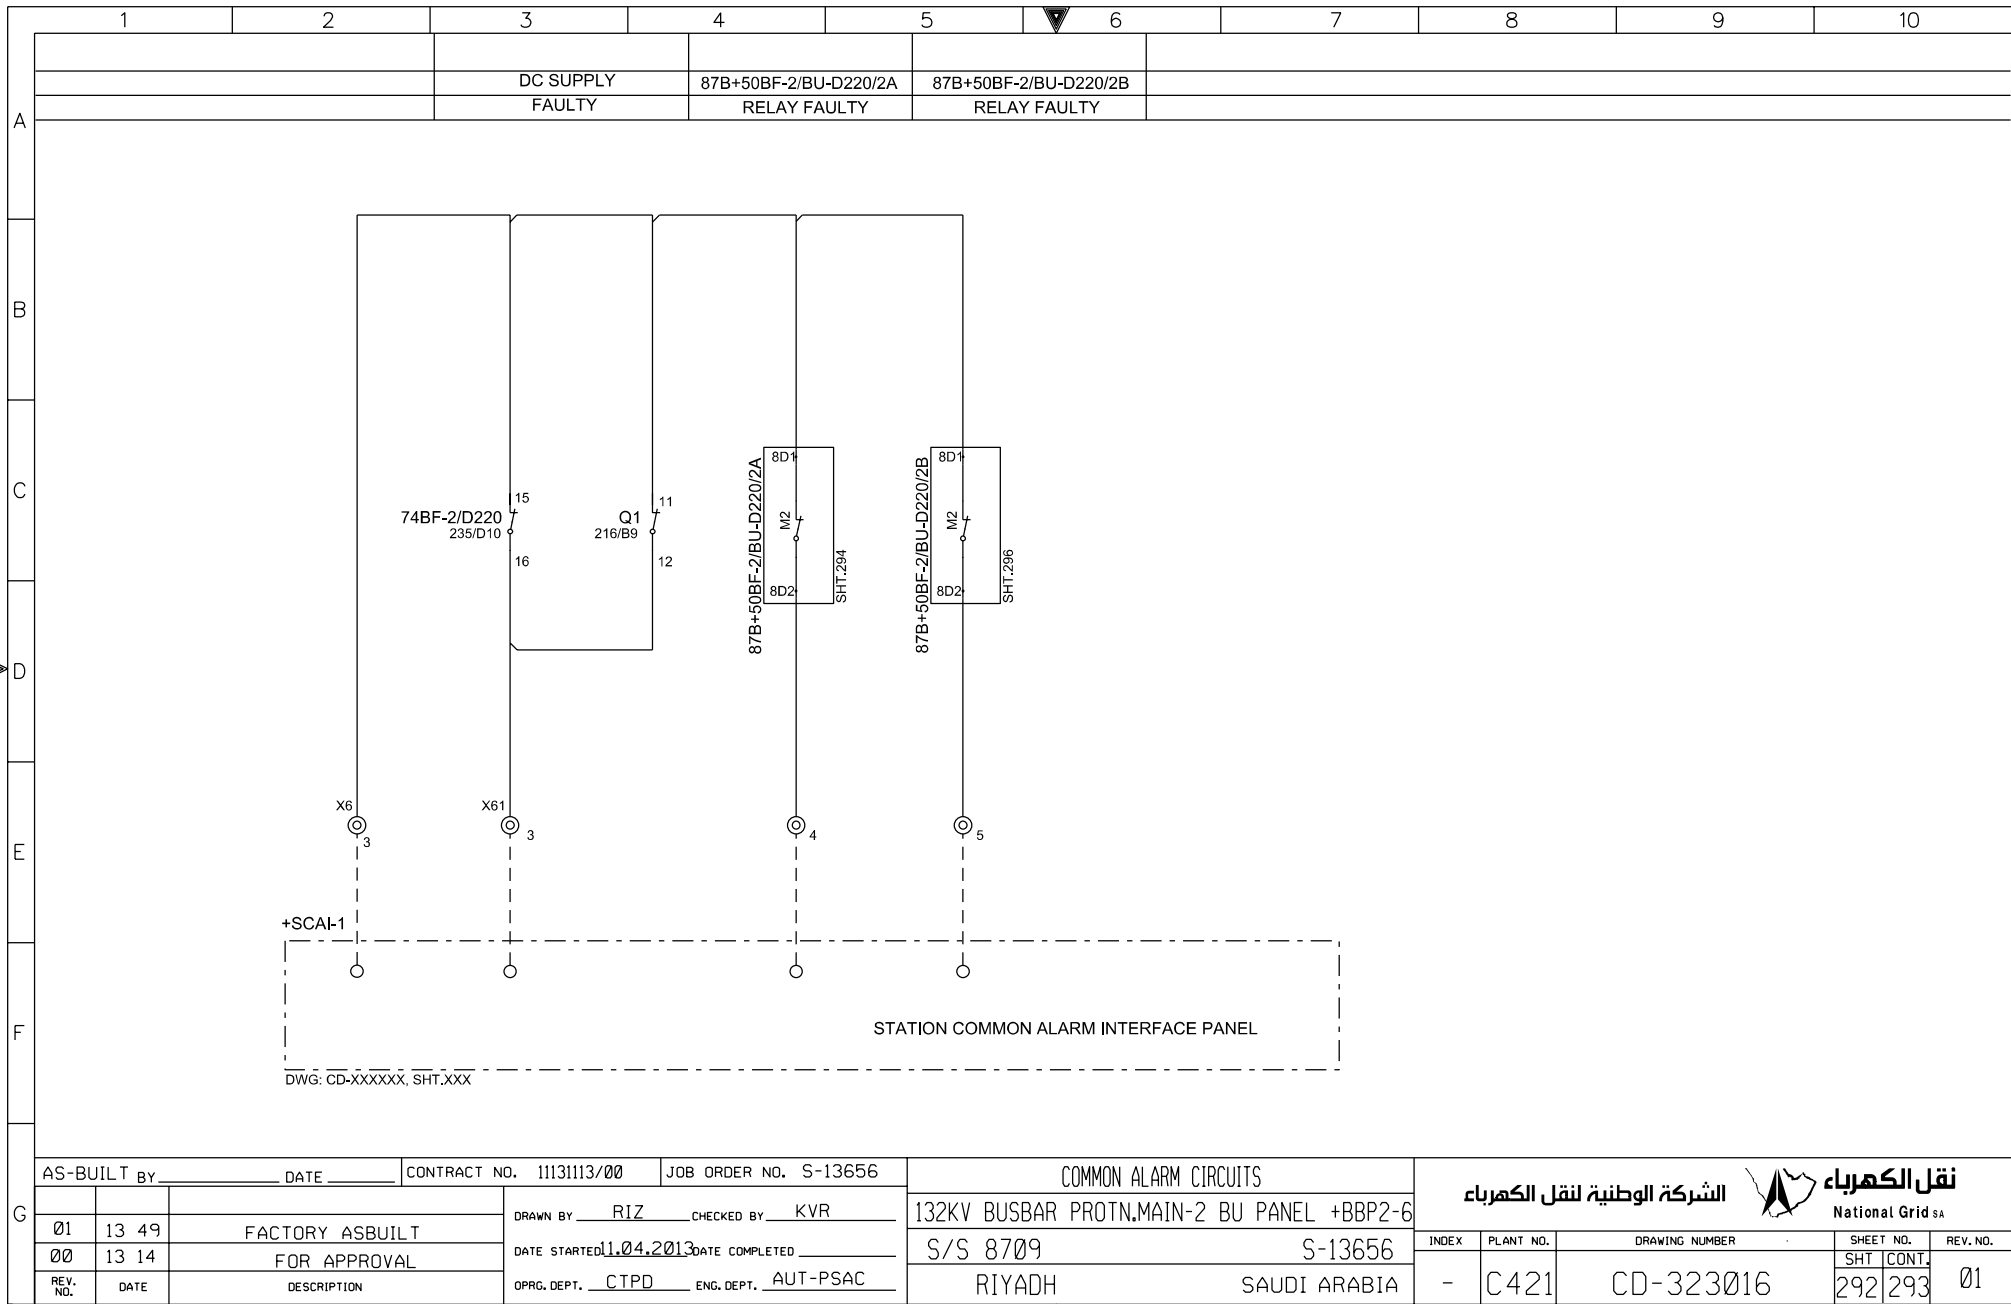


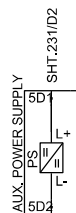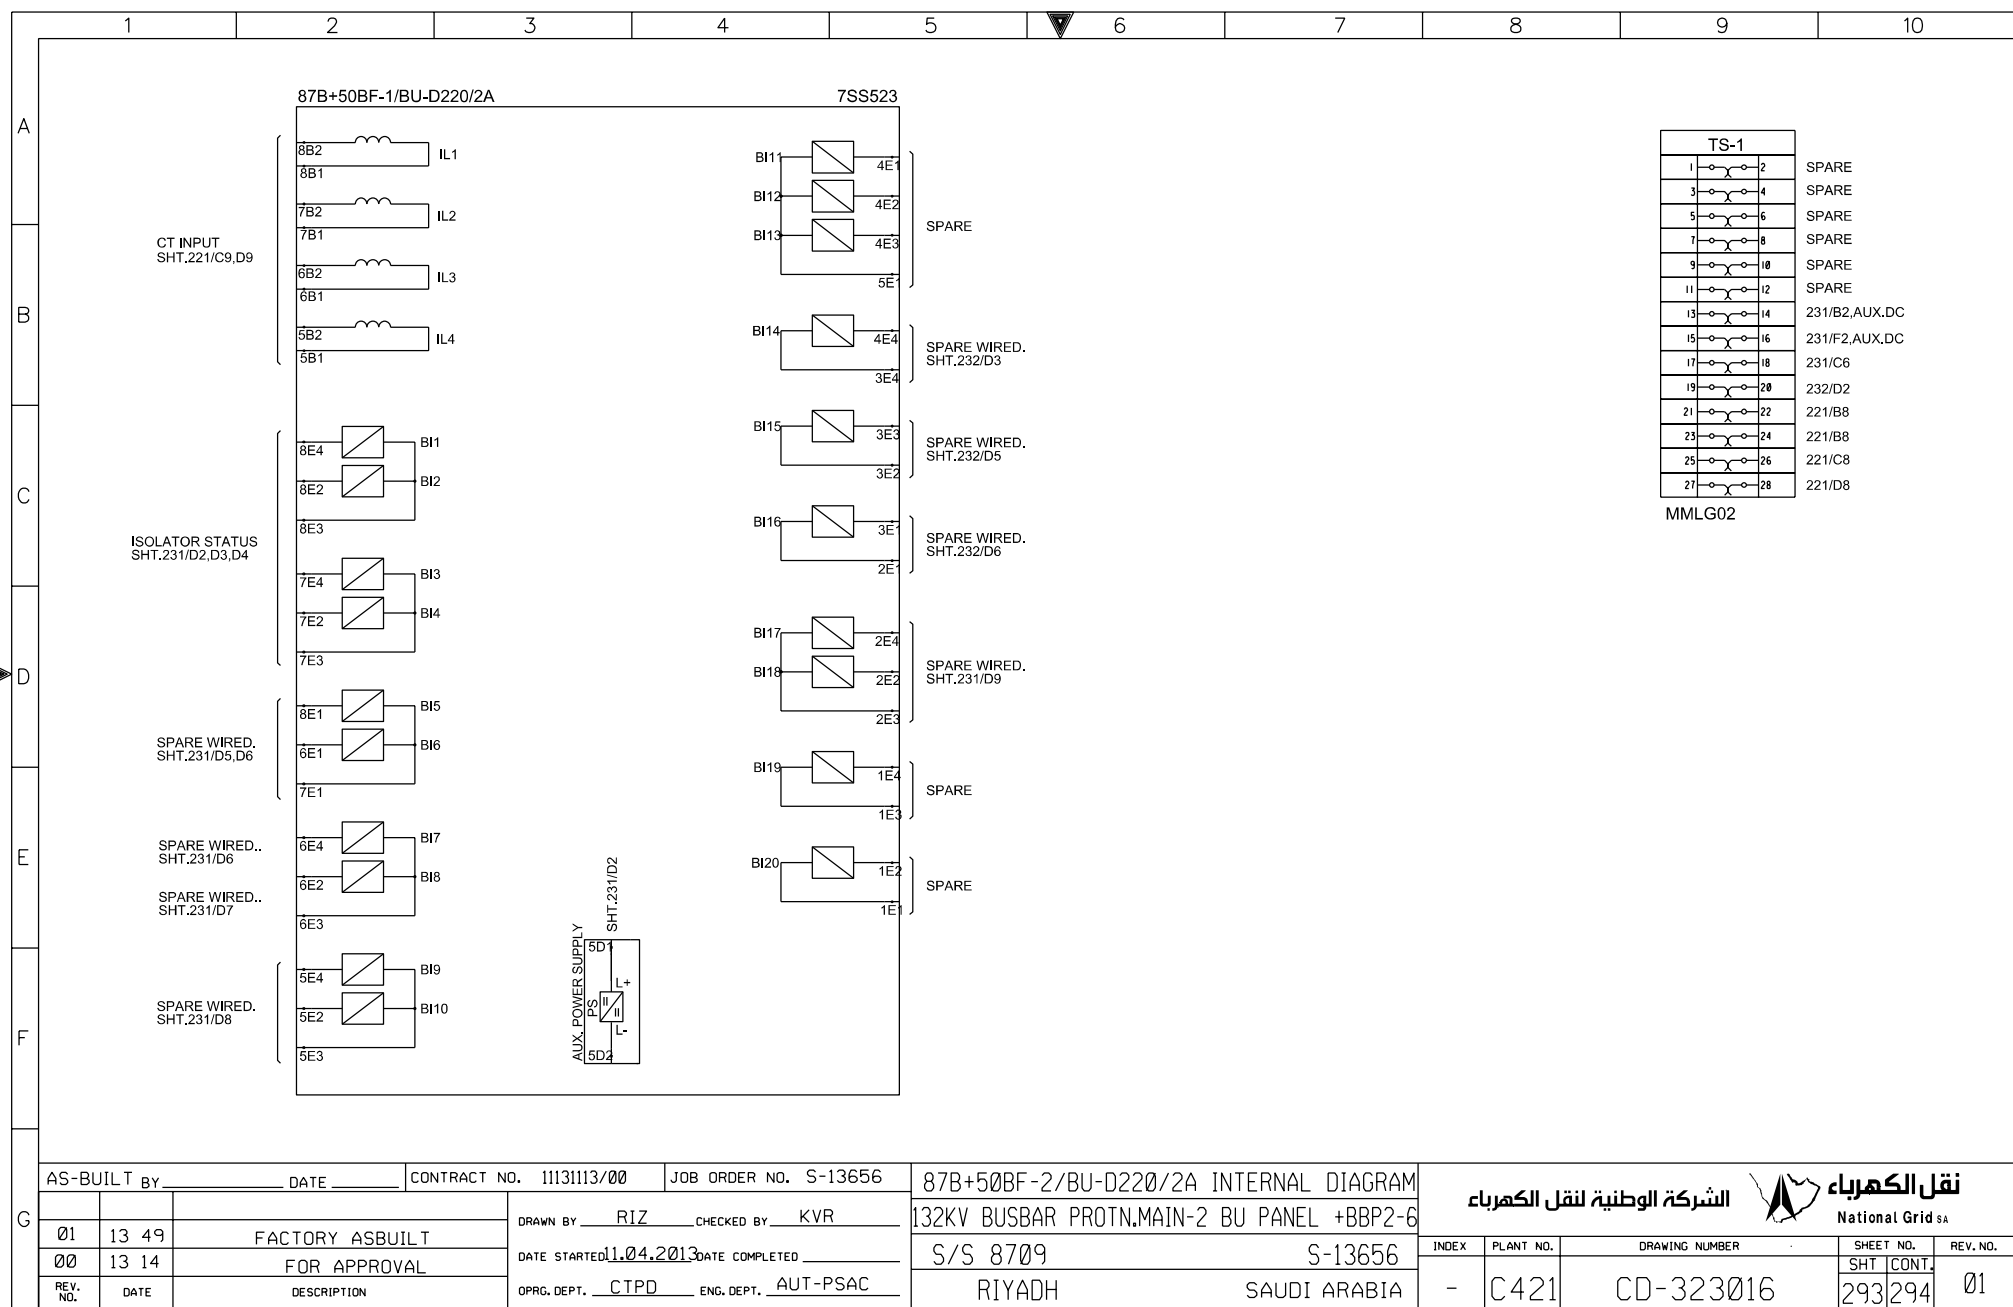

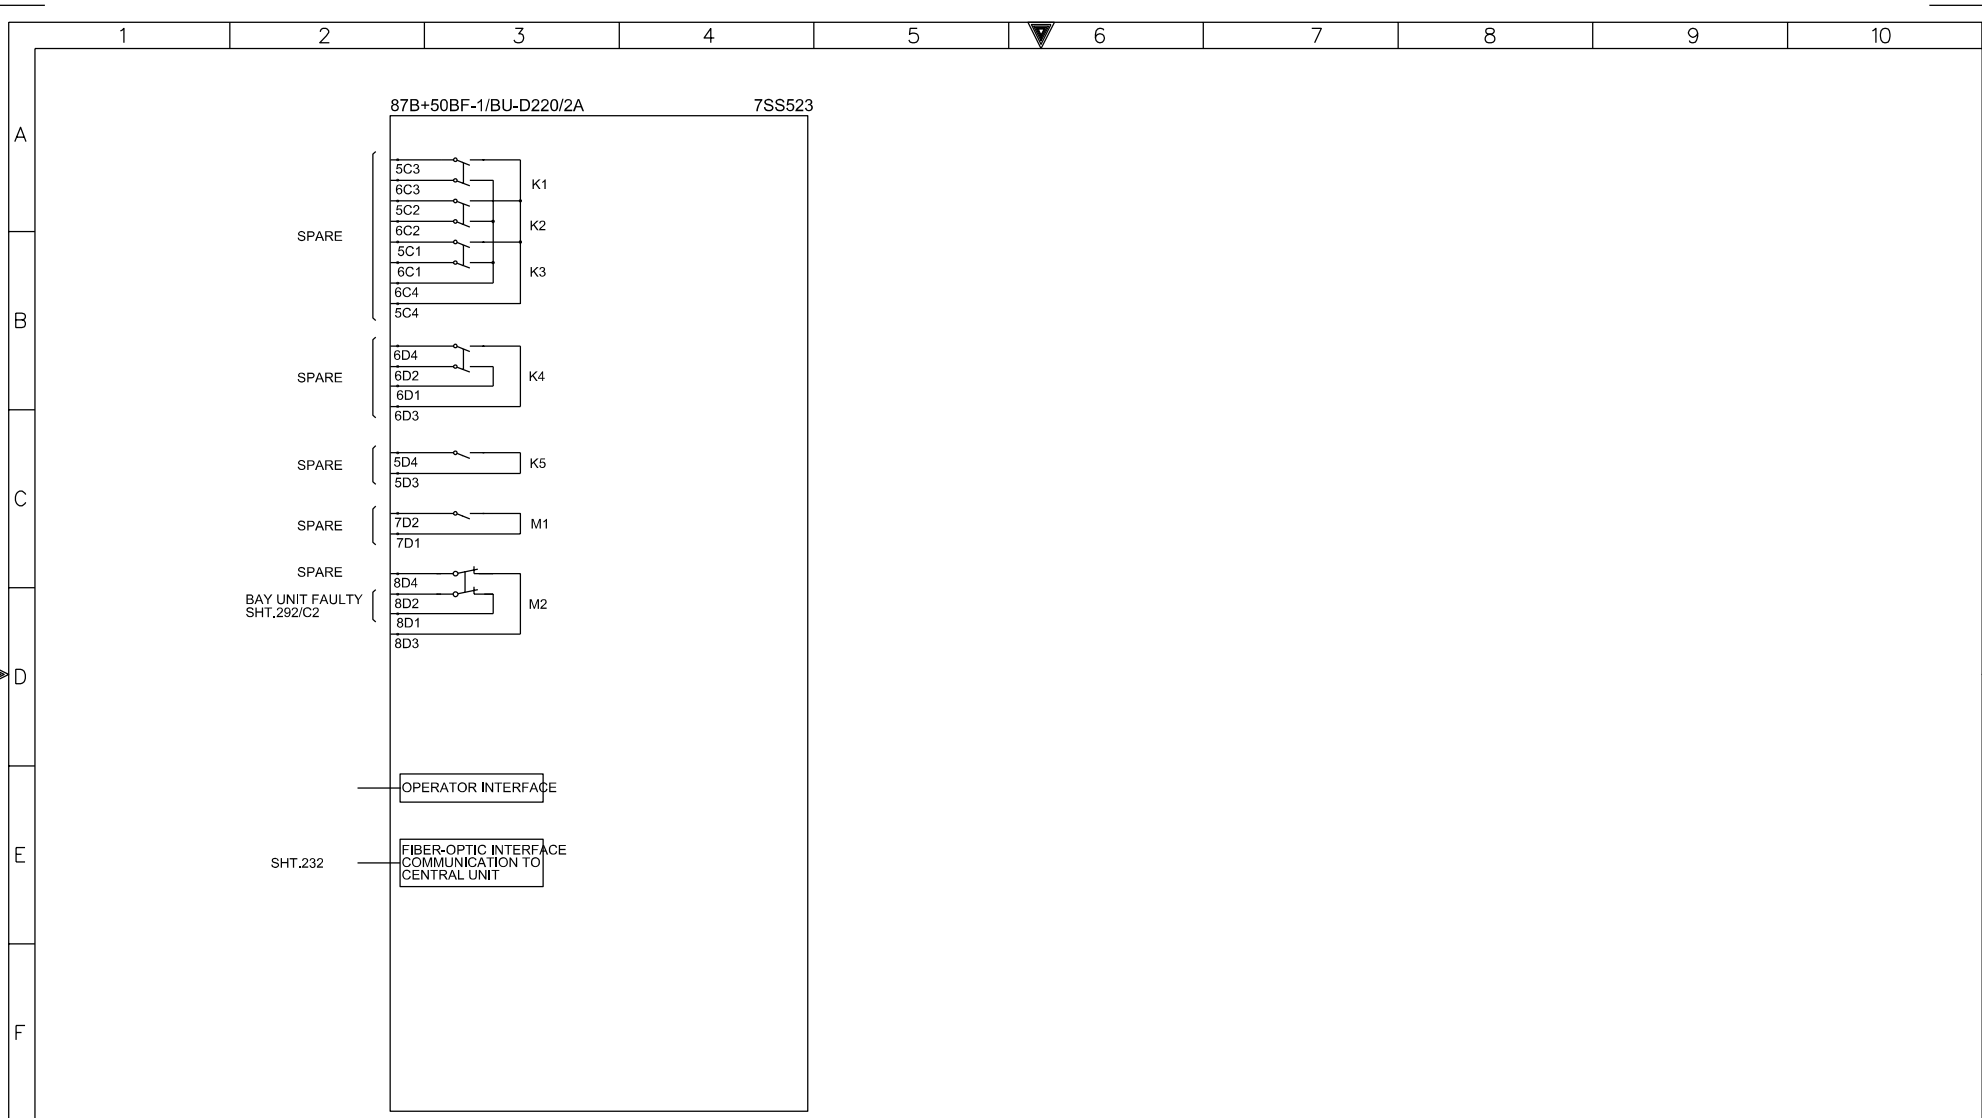


G

AS-BUILT BY _____ DATE _____			CONTRACT NO. 11131113/00		JOB ORDER NO. S-13656		87B+50BF-2/BU-D220/2A INTERNAL DIAGRAM				<div><div>الشركة الوطنية لنقل الكهرباء</div><div>نقل الكهرباء</div><div>National Grid SA</div></div>					
01	13 49	FACTORY ASBUILT FOR APPROVAL	DRAWN BY RIZ CHECKED BY KVR				132KV BUSBAR PROTN.MAIN-2 BU PANEL +BBP2-6									
00	13 14		DATE STARTED 11.04.2013 DATE COMPLETED _____				S/S 8709 S-13656									
REV. NO.	DATE	DESCRIPTION	OPRG. DEPT. CTPD		ENG. DEPT. AUT-PSAC		RIYADH		SAUDI ARABIA		INDEX	PLANT NO.	DRAWING NUMBER	SHEET NO.	REV. NO.	
											-	C421	CD-323016	SHT 294	CONT. 295	01

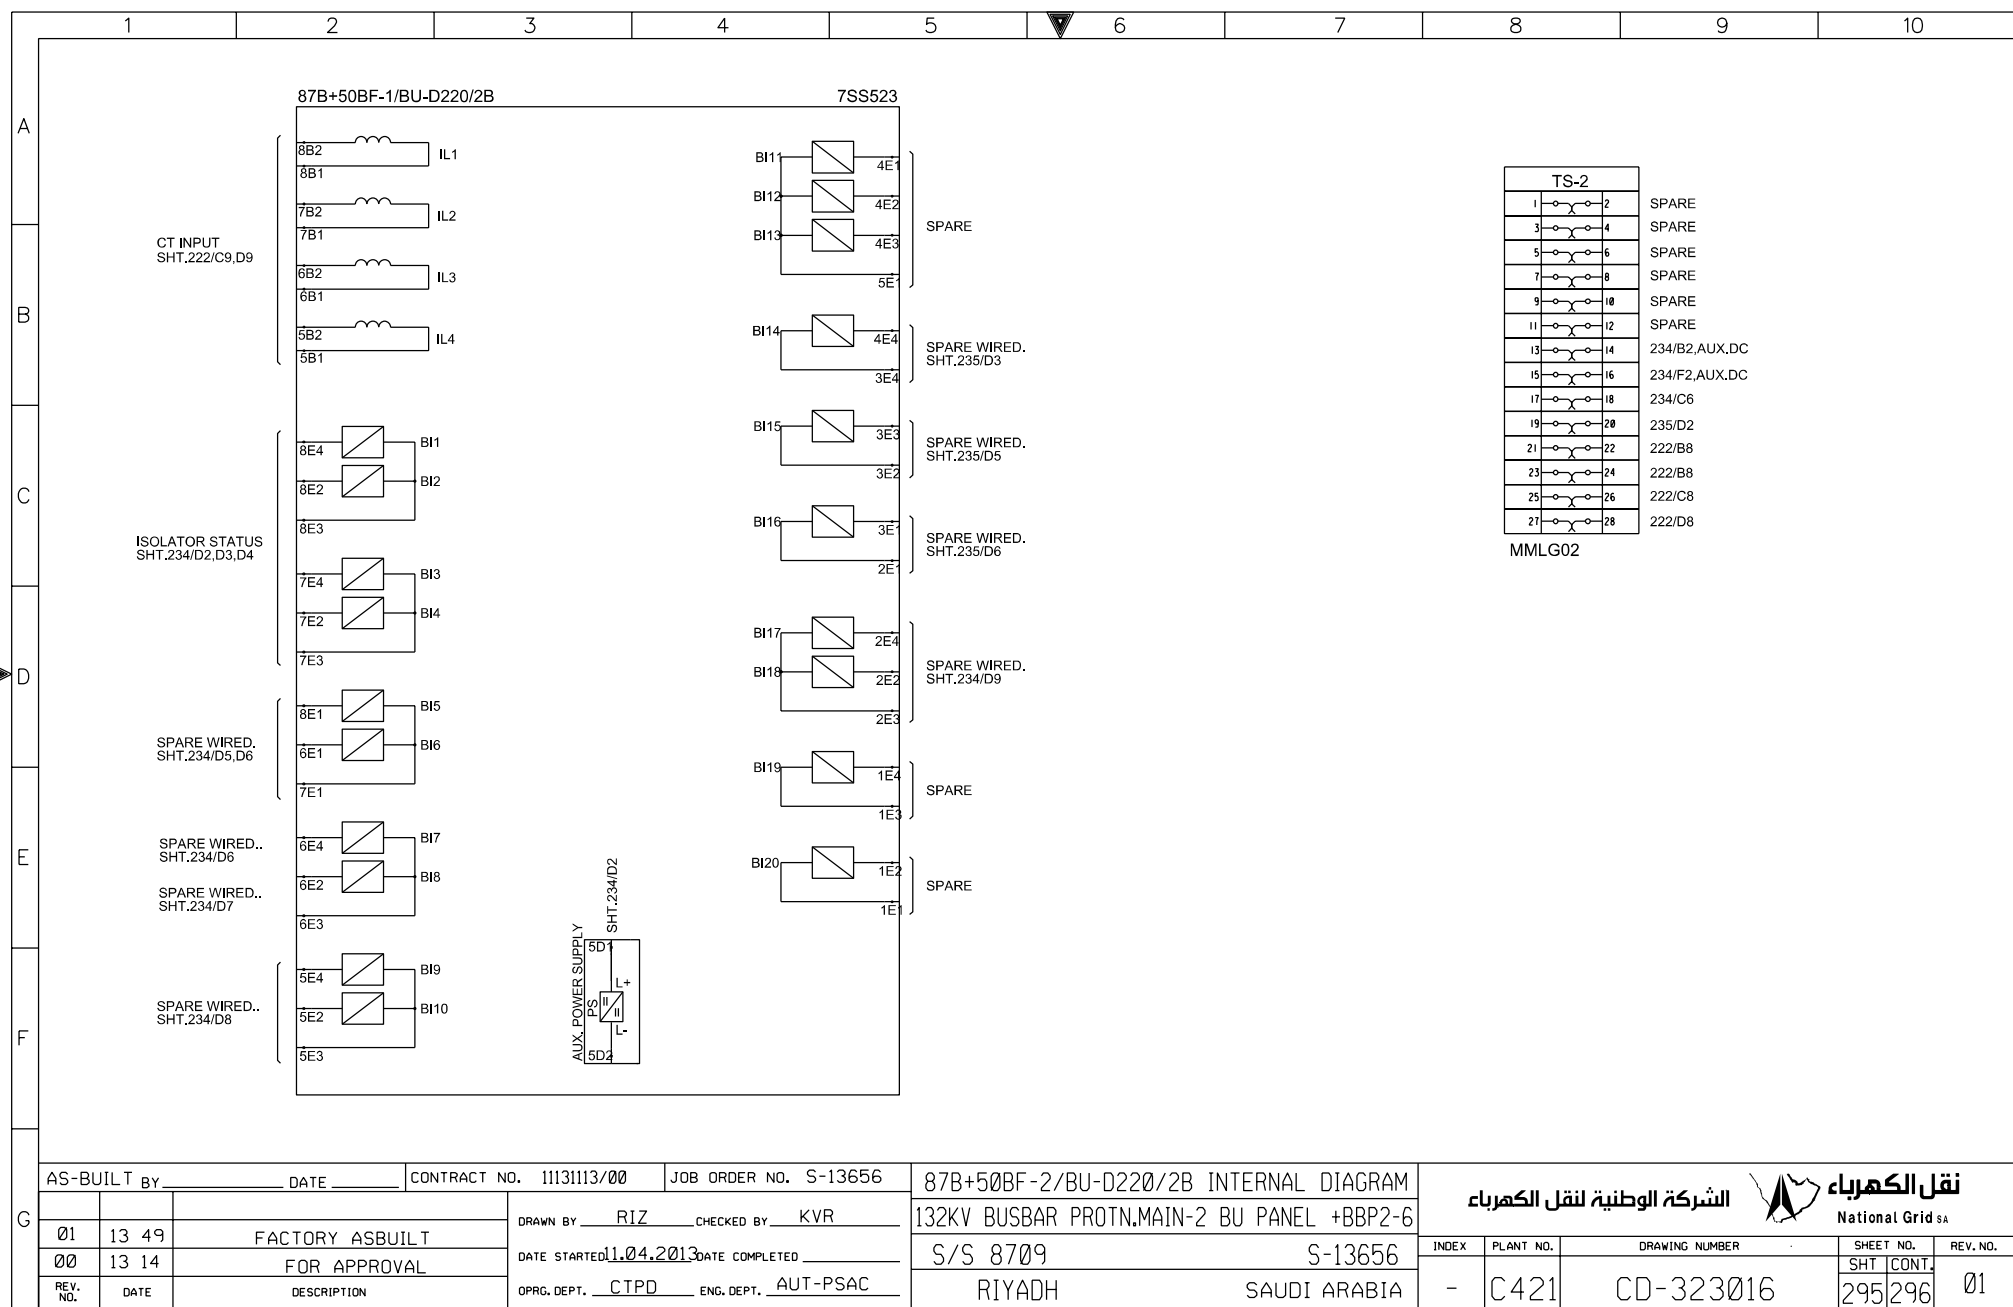

THIS DRAWING AND THE INFORMATION CONTAINED HEREIN ARE THE SOLE PROPERTY OF National Grid SA. NO REPRODUCTION IN FULL OR IN PART SHALL BE OBTAINED FROM THIS DOCUMENT WITHOUT THE WRITTEN CONSENT OF ITS OWNER.

87B+50BF-1/BU-D220/2B 7SS523

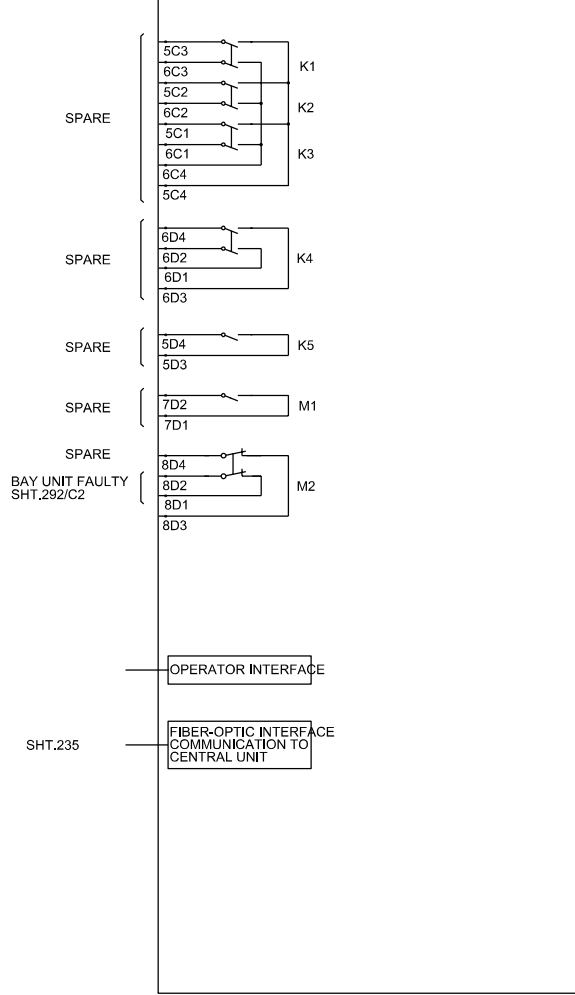

AS-BUILT BY _____ DATE _____ CONTRACT NO. 11131113/00 JOB ORDER NO. S-13656

01	13 49	FACTORY ASBUILT	DRAWN BY RIZ	CHECKED BY KVR
00	13 14	FOR APPROVAL	DATE STARTED 11.04.2013	DATE COMPLETED
REV. NO.	DATE	DESCRIPTION	OPRG. DEPT. CTPD	ENG. DEPT. AUT-PSAC

87B+50BF-2/BU-D220/2B INTERNAL DIAGRAM	
132KV BUSBAR PROTN.MAIN-2 BU PANEL +BBP2-6	
S/S 8709	S-13656
RIYADH	SAUDI ARABIA

الشركة الوطنية لنقل الكهرباء		نقل الكهرباء	
National Grid SA		National Grid SA	
INDEX	PLANT NO.	DRAWING NUMBER	SHEET NO.
-	C421	CD-323016	296/301
		REV. NO.	01

